

TALLAHATCHIE
F21
529-74

MISSISSIPPI
BOARD OF WATER COMMISSIONERS
416 North State Street
Jackson, Mississippi 39201

CODED

WATER WELL DRILLERS LOG

MAY 29 74
date well completed

DYER WELL & IRRIGATION SERVICE
firm name

TALLAHATCHIE
county well located

LANDOWNER:
DARRYL BATES
CLEVELAND, MISS.
(mailing address)


WELL LOCATION:
sec 27 T 25 N R 2 E
2 miles N.E. of CHARLESTON
(distance) (direction) (nearest town)

description of formations encountered	from	to
CLAY	0	15
SAND	15	31
COARSE SAND	31	38
COARSE SAND & PEP ROCK	38	57
GRAVEL	57	109

WELL PURPOSE: IRR.
(home, irrigation, municipal, industrial)

- WELL COMPLETION DATA:
- (1) diameter (inches) 16
 - (2) total depth (feet) 109'
 - (3) static water level (feet) 9' below top of ground.
 - (4) casing 16" (size) if telescope see back.
B2K IR, 69' (material) (depth)
 - (5) screen 16" (size) 40 (length) 69' (depth to top)
BR INGOT (material)
 - (6) pump 60 (HP) 3000 (yield gpm)
DIESEL (type power)
 - (7) electric log NO (yes or no)
 - (organization running log)
 - (8) how well bottom plugged RATE

CODED

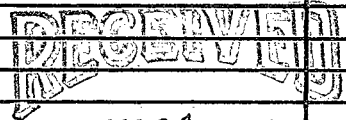


NOV 21 1974

DRILLERS REMARKS:

MISS. BD. OF WATER COMM.

If well telescopes please
sketch and show depths.

GROUND LEVEL

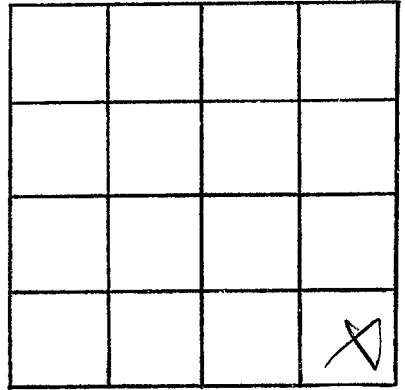

SECTION 27

Please indicate well location X.

ADDITIONAL INFORMATION

If more than one screen,
show locations of each on sketch.