

Tallahatchie  
F 22  
8-68

MISSISSIPPI  
 BOARD OF WATER COMMISSIONERS  
 416 North State Street  
 Jackson, Mississippi 39201

CODED

WATER WELL DRILLERS LOG

8-19-68 date well completed      Forde County, Jameson firm name      Tallahatchie county well located


LANDOWNER: Mrs T.H. Sims  
 (mailing address)  
 WELL LOCATION:  
 sec 1 T 25 N R 2  
1/4 miles W of Yauco  
 (distance) (direction) (nearest town)

description of formations encountered	from	to
<u>TOP SOIL &amp; clay</u> <u>brushcut</u>		<u>00</u>
<u>Screened sand gravel</u>		<u>100</u>
<u>Solid Rock at 100</u>		

WELL PURPOSE: Drinking  
 (home, irrigation, municipal, industrial)

CODED


WELL COMPLETION DATA:  
 (1) diameter (inches) 2  
 (2) total depth (feet) 90  
 (3) static water level (feet) 16 below top of ground.  
 (4) casing 2" SV (material), 84 (depth)  
2 (size) if telescope see back.  
 (5) screen 6" (length), 84 (depth to top)  
2 (size), Bung Whapped (material)  
 (6) pump None (HP), None (yield gpm)  
 (type power)  
 (7) electric log \_\_\_\_\_ (yes or no)  
 (organization running log)  
 (8) how well bottom plugged Point

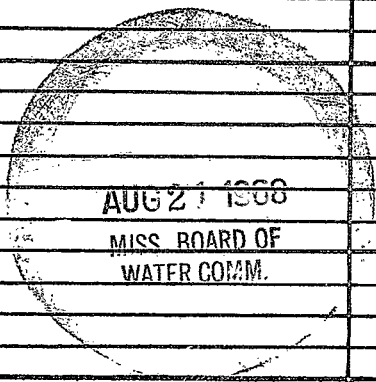

DRILLERS REMARKS:

If well telescopes please sketch and show depths.

GROUND LEVEL

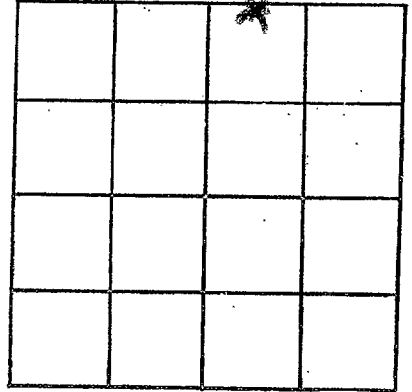

SECTION \_\_\_\_\_

Please indicate well location X.

ADDITIONAL INFORMATION

If more than one screen,  
show locations of each on sketch.