

TALLAHATCHIE

F 26

4-9-73

MISSISSIPPI BOARD OF WATER COMMISSIONERS 416 North State Street Jackson, Mississippi 39201

CODER

WATER WELL DRILLERS LOG

4-9

1923 James A. Lipe

Tallahatchie

date well completed

firm name

county well located

LANDOWNER:	description of formations encountered	from	to
Edward Little	Top Soil	0	20
Charleston Miss,	Sand	20	40
(mailing address)	ll	40	100
	Gravel	100	126
	Clay	126	140
	Sand	140	160
	Sand and clay	160	180
	ll	180	200
	Sand	200	220
	ll	220	241

WELL LOCATION:

sec 17 T 25 N R 2 E W 2 miles N.W. of Charleston (distance) (direction) (nearest town)

WELL PURPOSE: HOME (home, irrigation, municipal, industrial)

WELL COMPLETION DATA:


- (1) diameter (inches) 2
- (2) total depth (feet) 241
- (3) static water level (feet) 0 below top of ground.
- (4) casing galv. 131 (material) (depth) 2 (size) If telescope see back.
- (5) screen 10 131 (length) (depth to top) 2 (size) S.S. (material)
- (6) pump flowing 5 (HP) (yield gpm) No (type power)
- (7) electric log No (yes or no) No (organization running log)
- (8) how well bottom plugged galv plug

CODER

DRILLERS REMARKS:

If well telescopes please sketch and show depths.

GROUND LEVEL

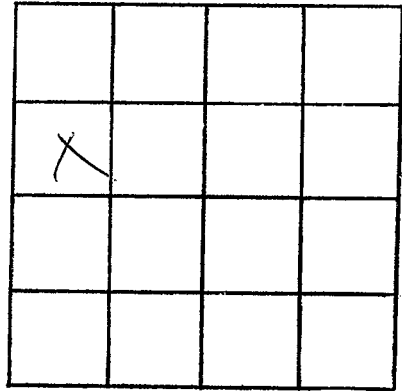

SECTION 17

Please indicate well location X.

ADDITIONAL INFORMATION

Lined area for additional information.

If more than one screen, show locations of each on sketch.