

TALLAHATCHIE
 F32
 7173
 log #43

MISSISSIPPI
 BOARD OF WATER COMMISSIONERS
 416 North State Street
 Jackson, Mississippi 39201

CODED

WATER WELL DRILLERS LOG

C16948

June 9, 1973 Singer-Layne Central Division Tallahatchie
 date well completed firm name county well located

LANDOWNER: City of Charleston
 Industrial Park
 Charleston, Mississippi

description of formations encountered	from	to
Clay	0	9
Coarse sand & pea gravel	9	24
Clay	24	80
Sand & gravel	80	135
Clay	135	147
Shale	147	169
Sand & strks. of shale	169	195
Sandy shale	195	247
Shale	247	311
Shale & strks. sandy s		
shale	311	338
Sand	338	352
Sandy shale	352	375
Shale	375	438
Shale & sand strks.	438	487
Sand	487	527
Shale	527	536
Rock	536	537
Shale	537	571
Rock	571	572
Sandy shale	572	707
Shale	707	841
Sand	841	860
Shale	860	962
Fine sand	962	1006
Shale	1006	1022
Rock, strks & shale	1022	1026
Shale	1026	1158
Rock	1158	1159
Shale	1159	1195
Sandy shale	1195	1243
Shale	1243	1300

WELL LOCATION:
 sec. 26 T. 25 N R. 2 E
 xXx xXx
 Industrial Park
 miles of (distance) (direction) (nearest town)

WELL PURPOSE: industrial
 (home, irrigation, municipal, industrial)

WELL COMPLETION DATA:

- (1) diameter (inches) 12 x 8
- (2) total depth (feet) 1012'5"
- (3) static water level (feet) 11'3" below top of ground.
- (4) casing Steel 965'4"
 (material) (depth)
 12" & 8" if telescope see back.
 (size)
- (5) screen 40' 1005'
 (length) (depth to top)
 8" stainless steel
 (size) (material)
- (6) pump 60 500
 (HP) (yield gpm)
 7.1" B.P.V.
 electric (type power)
- (7) electric log yes
 (yes or no)
 U.S.G.S.
 (organization running log)
- (8) how well bottom plugged B.P.V.


CODED

DRILLERS REMARKS:

JUL 19 1973

If well telescopes please sketch and show depths.

GROUND LEVEL

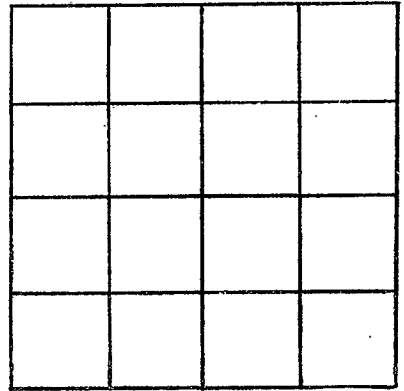

SECTION _____

Please indicate well location X.

ADDITIONAL INFORMATION

If more than one screen,
show locations of each on sketch.