

TALLAHATCHIE  
 F 33  
 6-11-73

MISSISSIPPI  
 BOARD OF WATER COMMISSIONERS  
 416 North State Street  
 Jackson, Mississippi 39201

**CODED**

WATER WELL DRILLERS LOG

6-11

1973 James R. Lipe

Tallahatchie

date well completed

firm name

county well located

LANDOWNER:	description of formations encountered	from	to
E. B. Bishop Charleston Miss. (mailing address)			
	sand	20	40
	"	40	80
	"	80	100
WELL LOCATION:	clay and sand	100	120
sec. 17 T. 25 (N) S. R. 2 (E)	clay	120	140
2 miles north of Charleston (distance) (direction) (nearest town)	"	140	160
	"	160	180
	"	180	200
WELL PURPOSE:	sand	200	230
(home) Irrigation, municipal, industrial			

- WELL COMPLETION DATA:
- (1) diameter (inches) 2
  - (2) total depth (feet) 230
  - (3) static water level (feet) flowing below top of ground.
  - (4) casing galv. 120  
(material) (depth)  
2"  
(size) if telescope see back.
  - (5) screen 10 120  
(length) (depth to top)  
2 S. S.  
(size) (material)
  - (6) pump 1/2 8  
(HP) (yield gpm)  
elec.  
(type power)
  - (7) electric log no  
(yes or no)  
no  
(organization running log)
  - (8) how well bottom plugged galv.  
plug


**CODED**

DRILLERS REMARKS:

JUL 5 1973

If well telescopes please sketch and show depths.

GROUND LEVEL

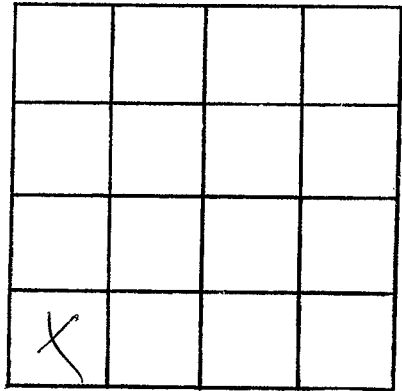

SECTION 17

Please indicate well location X.

ADDITIONAL INFORMATION

A series of horizontal lines for writing additional information.

If more than one screen, show locations of each on sketch.