

MISSISSIPPI DEPARTMENT OF NATURAL RESOURCES

Bureau of Land and Water Resources

Southport Mall

P.O. Box 10631

Jackson, Mississippi 39209

WATER WELL DRILLERS LOG

Griner Drilling Service, Inc.

Tallahatchie

~~Tallahatchie~~
F 48

890
Coded

9-18-90

date well completed

firm name

county well located


LANDOWNER:	description of formations encountered	from	to
W.S. "Red" Hancock Oilfield Construction P.O. Box 207 Benton, Ms. 39040 (mailing address)	Clay	0	60
WELL LOCATION: 1300'S + 1000'E sec. 27 T 25 N R 2 E OF No. 1 <u>Charleston</u> (distance) miles (direction) of (nearest town)	sand, pea gravel	60	130
WELL PURPOSE: <u>oilfield rig supply</u> (home, irrigation, municipal, industrial)			
WELL COMPLETION DATA:			
(1) diameter (inches) <u>4"</u>			
(2) total depth (feet) <u>130'</u>			
(3) static water level (feet) <u>15'</u> below above top of ground.			
(4) casing <u>PVC</u> , <u>110'</u> (material) (depth) <u>4"</u> (size) if telescope see back.			
(5) screen <u>20'</u> , <u>110' to 130'</u> (length) (depth to top)			
(6) pump <u>4"</u> , <u>PVC screen</u> (size) (material)			
(7) pump <u>90 GPM</u> (HP) (yield gpm)			
<u>Air Compressor</u> (type power)			
(7) electric log (yes or no) <u>no</u> (organization running log)			
(8) how well bottom plugged <u>4" PVC plug</u>			
DRILLERS REMARKS:			

RECEIVED
OCT 31 1990

Department of Natural Resources
Bureau of Land & Water Resources

If well telescopes please
sketch and show depths.

GROUND LEVEL

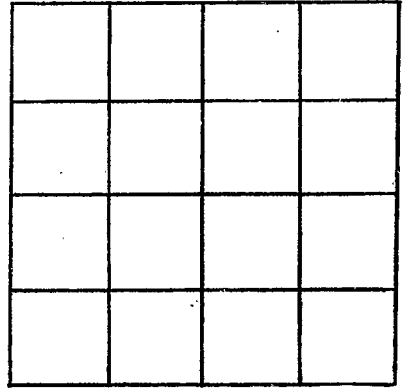

SECTION _____

Please indicate well location X.

ADDITIONAL INFORMATION

If more than one screen,
show locations of each on sketch.