

MISSISSIPPI

BOARD OF WATER COMMISSIONERS

416 North State Street

Jackson, Mississippi 39201

Jackson
F 200

WATER WELL DRILLERS LOG

8/19 date well completed Lipa Well firm name Tallahatchee county well located

LANDOWNER: <u>Morris Slaga</u>	description of formations encountered	from	to
(mailing address)	Clay	0	10
WELL LOCATION: sec. <u>2</u> T <u>25</u> N R <u>2</u> E <u>5</u> miles <u>No.</u> of <u>Chickasaw</u> (distance) (direction) (nearest town)	Sand	10	70
WELL PURPOSE: <u>None</u> (home, irrigation, municipal, industrial)	Sand & clay	70	120
WELL COMPLETION DATA:	Sand	120	130
(1) diameter (inches) <u>4"</u>	Sand & clay	130	140
(2) total depth (feet) <u>100'</u>	Sand	140	100
(3) static water level (feet) <u>100'</u> ^{below} above top of ground.			
(4) casing <u>PVC</u> (material), <u>150'</u> (depth) <u>4"</u> (size) If telescope: see back.			
(5) screen <u>10'</u> (length), <u>150'</u> (depth to top) <u>4"</u> (size), <u>PVC</u> (material)			
(6) pump <u>3/4</u> (HP), <u>10</u> (yield gpm) <u>elec.</u> (type power)			
(7) electric log <u>No</u> (yes or no) (organization running log)			
(8) how well bottom plugged <u>Cap</u>			
DRILLERS REMARKS:			


DEPT. OF NATURAL RESOURCES
BUREAU OF LAND & WATER RESOURCES

OCT 16 1984

RECEIVED

If well telescopes please sketch and show depths.

GROUND LEVEL

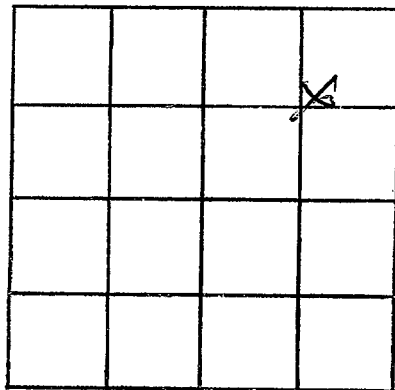

SECTION _____

Please indicate well location X.

ADDITIONAL INFORMATION

If more than one screen,
show locations of each on sketch.