

MISSISSIPPI DEPARTMENT OF ENVIRONMENTAL QUALITY
Bureau of Land and Water Resources

P. O. Box 10631
Jackson, MS 39289-0631
WATER WELL DRILLERS LOG

COUNTY WELL LOCATED	
Tallahatchie	
WELL NUMBER	CODED
Well - 1	
2005 F	
DATE WELL COMPLETED	
7/5/94	

PERMIT NUMBER
NAME OF DRILLING FIRM
Layne

NAME & MAILING ADDRESS OF LANDOWNER			
Roundsville Farm			
P.O. Box 55			
Charleston, MS 38921			
WELL LOCATION:	SEC	TOWNSHIP	RANGE
	29	25	(N) S (E) W
DISTANCE	DIRECTION	NEAREST TOWN	
3	Miles West	of Charleston	
OTHER LANDMARK			
WELL PURPOSE: Home (Irrigation), Municipal, Industrial, Fish Pond, etc.			

PUMP DATA		
PUMP TYPE (Circle One):		
(Submersible)	Turbine,	Jet Flowing Well,
Other (Describe) _____		
POWER TYPE (Circle One):		
(Electric)	Tractor,	Diesel, Gasoline, Butane,
Other (Describe) _____ H/P _____		
Pump Capacity (GPM)	No. of Stages	Setting Depth
500	1	60 FT.
PUMP TEST		
NOT TESTED		
Well yielded _____ GPM with		
a drawdown of _____ ft.		
after _____ hours of pumping		

WELL DATA		
Well Depth	Casing Diameter (In.)	Casing Length (Ft.)
98'	10"	58'
Type of Casing	Hole Depth	Depth to Static Water Level
PVC	103'	15'
TYPE OF COMPLETION: (Circle One or More):		
(Gravel Packer)	Underreamed,	Telescoped,
Natural Development,	Open Hole,	Other
(Describe) _____		
Top of Lap Pipe or Reduction in Casing		
N/A FEET IF TELESCOPED OR MORE THAN ONE SCREEN: USE BACK PAGE		

LOG DATA	
TYPE OF LOG RUN (Circle One):	
Electric, Gamma Ray, Density, Sonic, Neutron,	(No Log Run)
Other (Describe) _____	
Name of Organization Running Log	

SCREEN DATA		
Diameter - Inches	Length - Feet	Slot Size - Inches
10"	40'	.050"
Screen Type	Depth to Bottom - Feet	
PVC	98'	

GEOLOGIC DATA (Office Use Only)			
Surface Elev.	Geologic Unit	Unit Thickness	Depth to Top
Subs. SWL	Date	Analysis	Aquifer Test
Driller's Remarks			

DESCRIPTION OF FORMATIONS ENCOUNTERED	FROM	TO	FORMATIONS (Continued)	FROM	TO
Clay	0	35	<div style="border: 2px solid black; padding: 10px; font-size: 2em; font-weight: bold; transform: rotate(-5deg); display: inline-block;">RECEIVED</div>		
Sand	35	45			
Sand Gravel	45	98			
Clay	98	103			
			JUL 22 1994		
			Dept. of Environmental Quality Office of Land & Water Resources		
			IF MORE SPACE IS NEEDED, USE BACK		


If well telescopes please sketch and show depths.

GROUND LEVEL

SECTION _____

Please indicate well location X.

ADDITIONAL INFORMATION

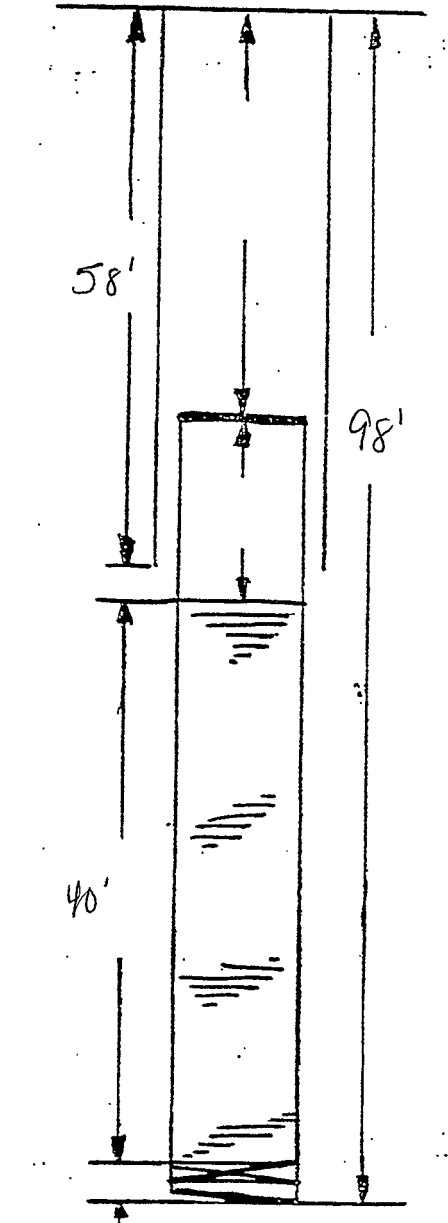

If more than one screen,
show location of each on sketch.