

Tallahatchie  
 CL-2086 F  
 F2008

MISSISSIPPI  
 BOARD OF WATER COMMISSIONERS  
 416 North State Street  
 Jackson, Mississippi 39201  
 WATER WELL DRILLERS LOG

3-22 1982 LAYNE CENTRAL CO. TALLAHATCHIE  
 date well completed firm name county well located

LANDOWNER:  
 J. W. BENAFIELD FARMS  
 CHARLESTON, MS  
 (mailing address)  
 WELL LOCATION: #1 of 2  
 sec. 8 T. 25 N. R. 2 E  
 3 miles NW of Charleston  
 (distance) (direction) (nearest town)

description of formations encountered	from	to
clay	0	18
sand	18	30
coarse sand	30	47
coarse sand & pea gravel	47	79
coarse sand & gravel	79	98
coarse sand & big gravel	98	110
coarse sand & gravel	110	120

WELL PURPOSE:  
 (home irrigation) municipal, industrial


WELL COMPLETION DATA:  
 (1) diameter (inches) 32"  
 (2) total depth (feet) 114'  
 (3) static water level (feet) 6' 6" below top of ground.  
 (4) casing steel 64' (material), (depth)  
 16" (size) if telescope see back.  
 (5) screen 50' 64' (length), (depth to top)  
 16" (size), st. steel (material)  
 (6) pump 60 2500 (HP) (yield gpm)  
 gear drive (type power)  
 (7) electric log no (yes or no)  
 (organization running log)  
 (8) how well bottom plugged st. plate

DEPT. OF NATURAL RESOURCES BUREAU OF LAND & WATER RESOURCES
JUN 24 1992
RECEIVED

DRILLERS REMARKS:

If well telescopes please sketch and show depths.

GROUND LEVEL

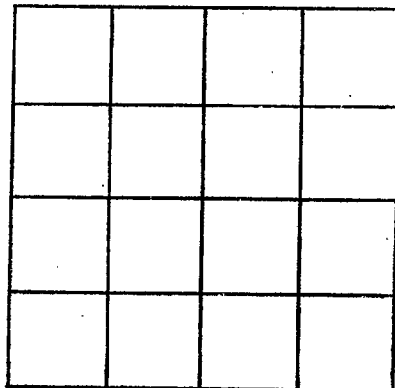

SECTION \_\_\_\_\_

Please indicate well location X.

ADDITIONAL INFORMATION

A series of horizontal lines for recording additional information.

If more than one screen, show locations of each on sketch.