

TALLA.

MISSISSIPPI BOARD OF WATER COMMISSIONERS

G3

7-10-60

WATER WELL DRILLERS LOG

CODED

Zallahatchie

Date: 7/10, 1960, Driller: James R. Gipe County Panola

(Name)

(1) Owner of Land: Bud Wiggins  
(Name)

Oakland Miss.  
(Address)

(2) Location: 1/4, 1/4, Sec 27 25 3 T. 9 N. R. 6 E.

1/2 miles W, Oakland  
(distance) (direction) (Nearest Town)

(3) Topography:  (Hilly)  (Flat)  (Level)

(4) Purpose of Well: Domestic  
(Domestic Irrigation, Municipal, Industrial, Other)

Description & Color of Materials Sand, Clay, Red Clay, Shell, etc.	Thick- ness Feet	Depth Feet
Clay	10	0-40
Clay & gravel	120	40-170
Coarse sand	10	170-180
Coarse sand	7	180-187

Information upon completion of well:

(1) Diameter 2 inches.

(2) Total Depth 147 feet.

(3) Water Level 130 feet below top of ground.

(4) Cased to 147, Size 2


(5) Screen: Size 1 1/4, Length 6

(6) Were any formations sealed against pollution?  
yes,  no.

If YES depth of formation \_\_\_\_\_

Why \_\_\_\_\_

Drillers Remarks: \_\_\_\_\_

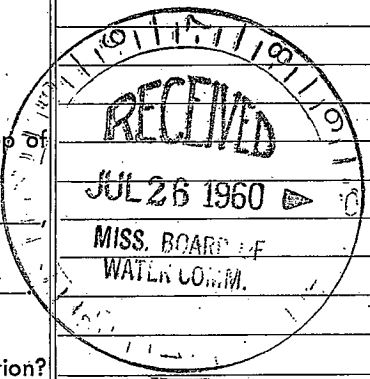

Well No. 3

(Use Back Side)

10  
11  
12  
100