

TALLA.

MISSISSIPPI BOARD OF WATER COMMISSIONERS

CODED

G 4
2-10-61

WATER WELL DRILLERS LOG

Zell Hutchie
Panola

Date: 2-10, 1961, Driller: J. R. Lyles

(Name)

County Panola

(1) Owner of Land: Morgan
(Name)
Charleston, Miss.
(Address)

(2) Location: 1/4, 1/4, Sec 20 25 3
T. N. R. E
3 miles east of Charleston
(distance) (direction) (Nearest Town)

(3) Topography: (Hilly) (Flat) (Level)


(4) Purpose of Well: (Domestic) Irrigation
Municipal, Industrial, Other

Information upon completion of well:

- (1) Diameter 2 inches.
- (2) Total Depth 177 feet.
- (3) Water Level 65 feet below top of ground.
- (4) Cased to 168, Size 2"
- (5) Screen: Size 1/4, Length 6'
- (6) Were any formations sealed against pollution?
yes, no.

If YES depth of formation
Why
Drillers Remarks:

Description & Color of Materials Sand, Clay, Red Clay, Shell, etc.	Thick- ness Feet	Depth Feet
Red clay	0	20
" "	20	25
gravel	75	125
clay	125	150
1/4" capricious sand	150	177

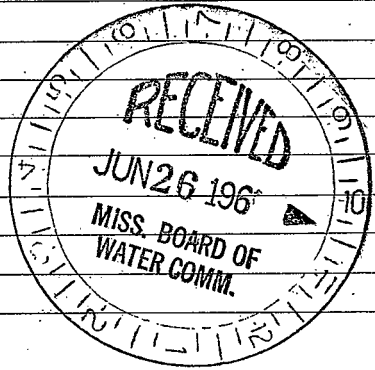

(Use Back Side)

Well No.

