

JALIA
G6

WATER WELL DRILLERS LOG

CODED

Ballastopolis

Date: July 19, 1962
7-19-62

Driller: Jas. R. Lyse County Joneta
(Name)

(1) Owner of Land: Collett
(Name)
Charleston, Miss
(Address)

(2) Location: $\frac{1}{4}$, $\frac{1}{4}$, Sec 23 T 25 R 3 E
4 miles east, of Charleston
(distance) (direction) (Nearest Town)

(3) Topography: Hilly
(Hilly) (Flat) (Level)

(4) Purpose of Well: Bait Shop
(Domestic Irrigation
Municipal, Industrial, Other)

| Description & Color of Materials Sand, Clay, Red Clay, Shell, etc. | Thick- ness Feet | Depth Feet |
|---|------------------------|----------------|
| <u>Clay</u> | <u>0</u> | <u>15</u> |
| <u>Gravel</u> | <u>15</u> | <u>80</u> |
| <u>Clay and sand</u> | <u>80</u> | <u>90</u> |
| <u>Water sand</u> | <u>90</u> | <u>133 1/2</u> |

Information upon completion of well:

(1) Diameter 2 inches.

(2) Total Depth 133 1/2 feet.

(3) Water Level 80 feet below top of ground.

(4) Cased to 126, Size 2".


(5) Screen: Size 1 1/4, Length 4'.

(6) Were any formations sealed against pollution?
_____ yes, _____ no.

If YES depth of formation _____

Why _____

Drillers Remarks: _____

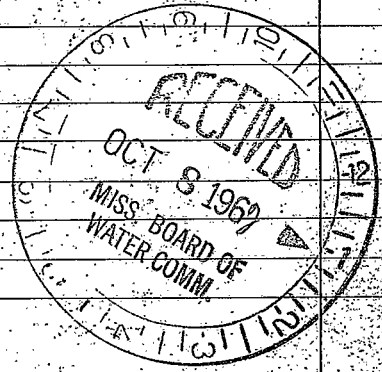

(Use Back Side)

Well No.

