

G7
5-13-63

WATER WELL DRILLERS LOG CODED


Date: 5/13, 1963, Driller: James R. Lipe County Orleans
(Name)

(1) Owner of Land:	Description & Color of Materials Sand, Clay, Red Clay, Shell, etc.	Thick- ness Feet	Depth Feet
<u>Jack Mason</u> (Name) <u>Charleston</u> (Address)	<u>Clay & Sand</u>	<u>0</u>	<u>25</u>
(2) Location: <u>1/4</u> , <u>1/4</u> , Sec. <u>19</u> ²⁵ <u>R</u> ³	<u>Clay</u>	<u>25</u>	<u>50</u>
<u>3</u> miles <u>east</u> of <u>Charleston</u> (distance) (direction) (Nearest Town)	<u>bank clay</u>	<u>50</u>	<u>90</u>
(3) Topography: <u>Hilly</u> (Hilly) (Flat) (Level)	<u>gravel & sand</u>	<u>90</u>	<u>105</u>
(4) Purpose of Well: <u>Domestic</u> (Domestic Irrigation Municipal, Industrial, Other)	<u>volcanic sand</u>	<u>105</u>	<u>135</u>

Information upon completion of well:

- (1) Diameter 2 inches.
- (2) Total Depth 135 feet.
- (3) Water Level 80 feet below top of ground.
- (4) Cased to 139, Size 2"
- (5) Screen: Size 1/4, Length 6'
- (6) Were any formations sealed against pollution?
_____ yes, _____ no.

If YES depth of formation _____
Why _____
Drillers Remarks: _____

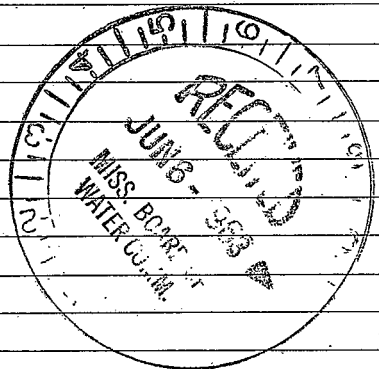

(Use Back Side)

Well No.

