

TALLA.

MISSISSIPPI BOARD OF WATER COMMISSIONERS

G 10  
4-24-64

WATER WELL DRILLERS LOG

CODED

Date: April 24, 1964, Driller: Frank Zylor <sup>2 pipe</sup> County Parola  
(Name)

(1) Owner of Land: <u>W.C. Adams</u> (Name)	Description & Color of Materials Sand, Clay, Red Clay, Shell, etc.	Thick- ness Feet	Depth Feet
<u>Charleston</u> (Address)	<u>Clay</u>	<u>0</u>	<u>45</u>
(2) Location: <u>1/4</u> , <u>1/4</u> , Sec. <u>17</u> <sup>26</sup> <u>T. N. R. 3</u> <sup>E</sup>	<u>Sand &amp; Clay</u>	<u>45</u>	<u>96</u>
<u>3</u> miles <u>east</u> of <u>Charleston</u> (distance) (direction) (Nearest Town)	<u>Gravel</u>	<u>96</u>	<u>112</u>
(3) Topography: <u>Hilly</u> (Hilly) (Flat) (Level)	<u>Gravel</u>	<u>112</u>	<u>140</u>
(4) Purpose of Well: <u>Domestic</u> (Domestic Irrigation Municipal, Industrial, Other)			


Information upon completion of well:

- (1) Diameter 2 inches.
- (2) Total Depth 140 feet.
- (3) Water Level 75 feet below top of ground.
- (4) Cased to 126, Size 2"
- (5) Screen: Size 1/4, Length 6'
- (6) Were any formations sealed against pollution?  
\_\_\_\_\_ yes, \_\_\_\_\_ no.

If YES depth of formation \_\_\_\_\_

Why \_\_\_\_\_

Drillers Remarks: \_\_\_\_\_

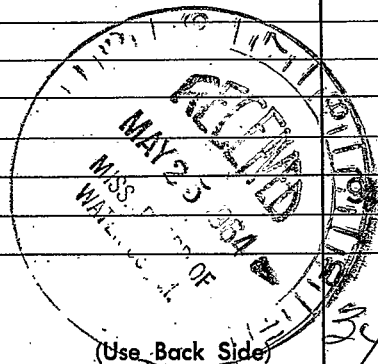

Well No. 34

[The page contains extremely faint and illegible text, likely bleed-through from the reverse side of the document. No specific words or phrases can be discerned.]