

MISSISSIPPI BOARD OF WATER COMMISSIONERS

G. J. Jallahatchie

CODED

WATER WELL DRILLERS LOG

Jallahatchie

10-28-64

Date: 10-28, 1964, Driller: Frank Lipe, Jr. County: Panola

(Name)

(1) Owner of Land: State Dept. of Ag. (Name)

Batesville, Miss. (Address)

(2) Location: 1/4, 1/4, Sec. 27 25 3 T. 4 R. E. 1

5 miles east of Charleston (distance, direction, Nearest Town)

(3) Topography: Hilly (Hilly, Flat, Level)

(4) Purpose of Well: Other (Domestic Irrigation, Municipal, Industrial, Other)

Description & Color of Materials Sand, Clay, Red Clay, Shell, etc. Thickness Feet Depth Feet

Clay & gravel	0	90
gravel	90	140
Bank clay	140	240
Sand	240	302
1/2 sand		

Information upon completion of well:

(1) Diameter 4 inches.

(2) Total Depth 302 feet.

(3) Water Level 80 feet below top of ground.

(4) Cased to top, Size 4"

(5) Screen: Size 4", Length 4"


(6) Were any formations sealed against pollution?

yes, no.

If YES depth of formation

Why

Drillers Remarks:

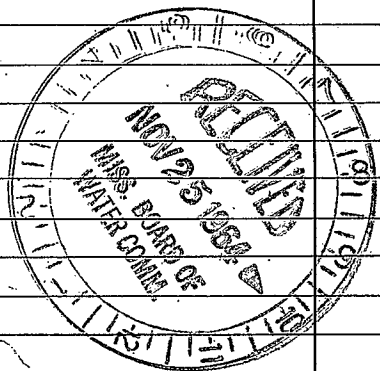

(Use Back Side)

Well No. 5

