

MISSISSIPPI BOARD OF WATER COMMISSIONERS

TALLA.

2 ipe

CODED

612 WATER WELL DRILLERS LOG

11-28-64

Driller Frank Taylor Tallahatchie  
 County Panola  
 (Name)

Date: 11-28, 1964, Driller

(1) Owner of Land: Dynes Bogg  
 (Name)  
Charleston  
 (Address)

(2) Location: 1/4, 1/4, Sec 29 T25 R30  
5 miles So. of Charleston  
 (distance) (direction) (Nearest Town)

(3) Topography: Flat  
 (Hilly) (Flat) (Level)

(4) Purpose of Well: Dom  
 (Domestic Irrigation  
 Municipal, Industrial, Other)

Description & Color of Materials Sand, Clay, Red Clay, Shell, etc.	Thick- ness Feet	Depth Feet
<u>Clay &amp; Sand</u>	<u>0</u>	<u>70</u>
<u>ground</u>	<u>70</u>	<u>80</u>
<u>Ground &amp; Sand</u>	<u>80</u>	<u>112</u>
<u>2 1/2 Sand</u>	<u>112</u>	<u>147</u>

Information upon completion of well:

(1) Diameter 4" inches.

(2) Total Depth 147 feet.

(3) Water Level 70 feet below top of ground.

(4) Cased to top, Size 4"


(5) Screen: Size 4", Length 6'

(6) Were any formations sealed against pollution?  
 \_\_\_\_\_ yes, \_\_\_\_\_ no.

If YES depth of formation \_\_\_\_\_

Why \_\_\_\_\_

Drillers Remarks: \_\_\_\_\_

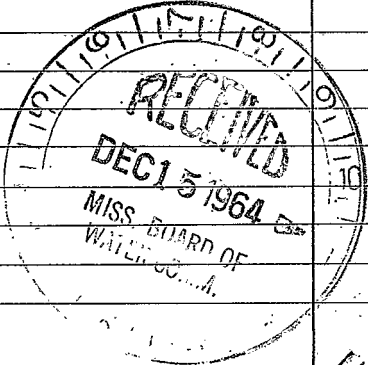

(Use Back Side)

Well No. 16

