

G 13
2-10-65

CODED

WATER WELL DRILLERS LOG

Date: 2/10, 1965, Driller: Frank Taylor County Tallahatchie
(Name)

(1) Owner of Land: SCOTT
(Name)
Charleston
(Address)

(2) Location: 1/4, 1/4, Sec. 15 25 3
(distance) (direction) (Nearest Town)
5 miles So. West of Depland

(3) Topography: Hilly
(Hilly) (Flat) (Level)

(4) Purpose of Well: Domestic
(Domestic Irrigation Municipal, Industrial, Other)

Description & Color of Materials Sand, Clay, Red Clay, Shell, etc.	Thick-ness Feet	Depth Feet
<u>Red Clay</u>	<u>0</u>	<u>23</u>
<u>Clay and gravel</u>	<u>23</u>	<u>43</u>
<u>Sand and gravel</u>	<u>43</u>	<u>63</u>
<u>11 11 11</u>	<u>63</u>	<u>83</u>
<u>Black Clay</u>	<u>83</u>	<u>103</u>
<u>11 11</u>	<u>103</u>	<u>123</u>
<u>11 11</u>	<u>123</u>	<u>143</u>
<u>Water sand</u>	<u>143</u>	<u>163</u>
<u>11 11</u>	<u>163</u>	<u>167</u>

Information upon completion of well:

(1) Diameter 4 inches.

(2) Total Depth 167 feet.

(3) Water Level _____ feet below top of ground.


(4) Cased to _____, Size 4"

(5) Screen: Size 4", Length 6'

(6) Were any formations sealed against pollution?
 _____ yes, _____ no.

If YES depth of formation _____
 Why _____

Drillers Remarks: _____

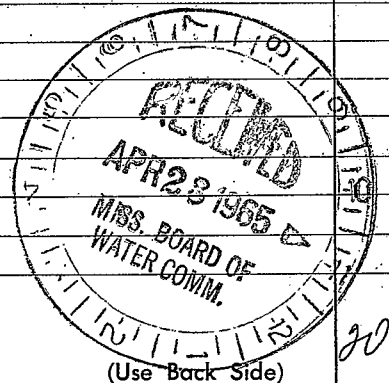

Well No. 20

