

TALLA. MISSISSIPPI BOARD OF WATER COMMISSIONERS

G 14
3-22-65

CODED

WATER WELL DRILLERS LOG

Date: 3.22, 1965, Driller: ^{Lipley} Frank Lyle County Tallahatchie
(Name)

(1) Owner of Land: Mrs. Wiggley
(Name)
Charleston
(Address)

(2) Location: 1/4, 1/4, Sec. 19 ²⁵³ _{T R E}
3 miles No. east of Charleston
(distance) (direction) (Nearest Town)

(3) Topography: Hilly
(Hilly) (Flat) (Level)

(4) Purpose of Well: Domestic
(Domestic Irrigation
Municipal, Industrial, Other)

Description & Color of Materials Sand, Clay, Red Clay, Shell, etc.	Thick- ness Feet	Depth Feet
Red Clay	0	23
Red clay and sand	23	43
Red sand	43	63
sand and gravel	63	95
black clay	95	123
water sand	123	138

Information upon completion of well:

(1) Diameter 4" inches.

(2) Total Depth 138' feet.

(3) Water Level 90' feet below top of ground.

(4) Cased to 132', Size 4"


(5) Screen: Size 4", Length 6"

(6) Were any formations sealed against pollution?
_____ yes, _____ no.

If YES depth of formation _____

Why _____

Drillers Remarks: _____

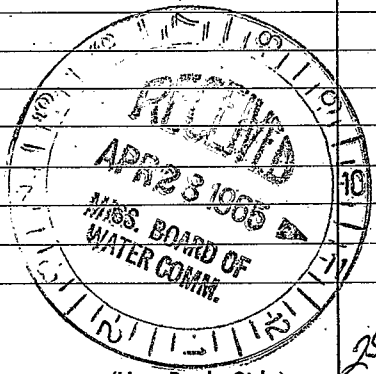

(Use Back Side)

Well No. 725

