

Tallahatchie
 G16
 12-68

MISSISSIPPI
 BOARD OF WATER COMMISSIONERS
 416 North State Street
 Jackson, Mississippi 39201

CODED

WATER WELL DRILLERS LOG

date well completed 19 68 James R. Lipe firm name Tallahatchie county well located

LANDOWNER: V. L. Rice

description of formations encountered

from

to

Oakland

MISS.

(mailing address)

WELL LOCATION:

sec. 2 T. 25 (N) R. 7 E. (W)
3 miles north west of Oakland
 (distance) (direction) (nearest town)

WELL PURPOSE: home
 (home, irrigation, municipal, industrial)

WELL COMPLETION DATA:

- (1) diameter (inches) 4
- (2) total depth (feet) 176'
- (3) static water level (feet) 80 below above top of ground.
- (4) casing Plastic 1 1/4
 (material) (depth)
- (size) if telescope see back. "
- (5) screen 12 1 1/4
 (length) (depth to top)
- 4 Plastic
 (size) (material)
- (6) pump 3/4 10
 (HP) (yield gpm)
- Elec.
 (type power)
- (7) electric log no
 (yes or no)

(organization running log)

(8) how well bottom plugged 4"
Plastic Plug


DRILLERS REMARKS:

JAN 2 1969

MADE BY DR. G. S. MARSH COMING

If well telescopes please sketch and show depths.

GROUND LEVEL

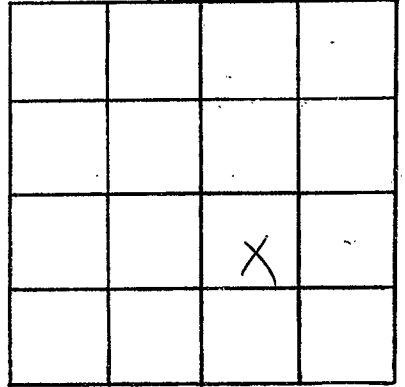

SECTION 2

Please indicate well location X.

ADDITIONAL INFORMATION

If more than one screen,
show locations of each on sketch.