

TALLAHATCHIE Big Stream well only

MISSISSIPPI
BOARD OF WATER COMMISSIONERS
416 North State Street
Jackson, Mississippi 39201

CODED TCHIE

WATER WELL DRILLERS LOG

~~XXXXXX~~
G-18
11-4-69

11-4-69 19
date well completed

11-4-69
firm name

Romola
county well located

LANDOWNER Walter Dorley

Enid
Miss
(mailing address)

description of formations encountered
hard clay
hard + sh
from 0 to 30
30 130

WELL LOCATION:

sec. 6 T 23 S R 2 E W
6 miles SW of Enid
(distance) (direction) (nearest town)

WELL PURPOSE:
(home, irrigation, municipal, industrial)

WELL COMPLETION DATA:

- (1) diameter (inches) 2"
- (2) total depth (feet) 130
- (3) static water level (feet) 100 below top of ground.
- (4) casing Steel, 125,
(material) (depth)
(size) if telescope see back.
- (5) screen 1/4, 125
(length) (depth to top)
1/4, Bron
(size) (material)
- (6) pump Rod 3
(HP) (yield gpm)
2
(type power)
- (7) electric log _____
(yes or no)
(organization running log)
- (8) how well bottom plugged _____

Log to
11-4-69
12 JES


CODED

DRILLERS REMARKS:

NOV 9
MISS. DIV. OF
WATER RESOURCES

If well telescopes please sketch and show depths.

GROUND LEVEL

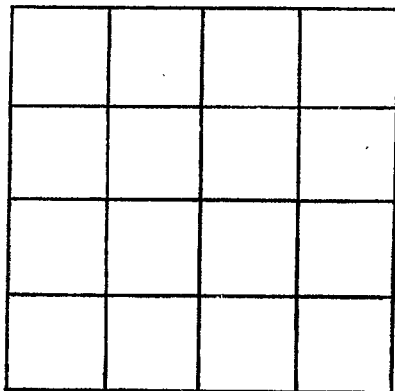

SECTION _____

Please indicate well location X.

ADDITIONAL INFORMATION

If more than one screen,
show locations of each on sketch.