

TALLAHATCHIE  
G 20  
6-4-71

MISSISSIPPI  
BOARD OF WATER COMMISSIONERS  
416 North State Street  
Jackson, Mississippi 39201

WATER WELL DRILLERS LOG **CODED**

June 4 1971 date well completed  
Lipe Well Co. firm name  
Tallahatchie county well located

LANDOWNER:  
Willie Holland  
Charleston, Miss  
(mailing address)

description of formations encountered	from	to
top soil	0	10
sand & clay	10	15
sand	15	30

WELL LOCATION:  
sec. 34 T 25 N R 3 E  
8 miles E of Charleston  
(distance) (direction) (nearest town)

WELL PURPOSE:  
(home, irrigation, municipal, industrial)

- WELL COMPLETION DATA:
- (1) diameter (inches) 4"
  - (2) total depth (feet) 99
  - (3) static water level (feet) 30 below above top of ground.
  - (4) casing PVC 71' (material) (depth)  
4" (size) If telescope see back.
  - (5) screen 8' 71' (length) (depth to top)  
4" (size) PVC & silica (material)
  - (6) pump 3/4 10 (HP) (yield gpm)  
elec. (type power)
  - (7) electric log no (yes or no)  
✓ (organization running log)
  - (8) how well bottom plugged PVC cap

**CODED**


OCT 12 1971

DRILLERS REMARKS:

MISS. BD. OF  
WATER COMM.

If well telescopes please sketch and show depths.

GROUND LEVEL

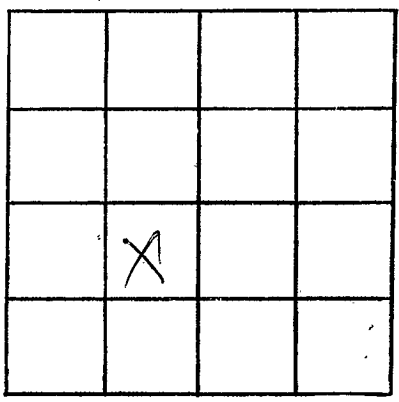

SECTION 39

Please indicate well location X.

ADDITIONAL INFORMATION

Lined area for additional information.

If more than one screen, show locations of each on sketch.