

TALLAHATCHIE
G 21
12-4-71

MISSISSIPPI
BOARD OF WATER COMMISSIONERS
416 North State Street
Jackson, Mississippi 39201

DEC 20 1971

WATER WELL DRILLERS LOG

CODED TALLAHATCHIE

Dec 4 1971 LIPE WELL CO. date well completed firm name county well located

LANDOWNER:
G.P. Morgan
Charleston, Miss
(mailing address)

description of formations encountered	from	to
top soil	0	10
red sand	10	20
gravel	20	60
sand	60	100
clay	100	120
sand	120	195

WELL LOCATION:
sec 19 T 25 S R 3 E
5 miles E of Charleston
(distance) (direction) (nearest town)

WELL PURPOSE: home
(home, irrigation, municipal, industrial)


- WELL COMPLETION DATA:
- (1) diameter (inches) ~~7 1/2~~ 4"
 - (2) total depth (feet) 195'
 - (3) static water level (feet) 80 ^{below}/_{above} top of ground.
 - (4) casing PVC 187
(material) (depth)
4" (size) If telescope see back.
 - (5) screen 8' 187
(length) (depth to top)
4" PVC & screen
(size) (material)
 - (6) pump 3/4 10
(HP) (yield gpm)
elec
(type power)
 - (7) electric log NO
(yes or no)
✓
(organization running log)
 - (8) how well bottom plugged PVC cap

CODED

DRILLERS REMARKS:

If well telescopes please sketch and show depths.

GROUND LEVEL

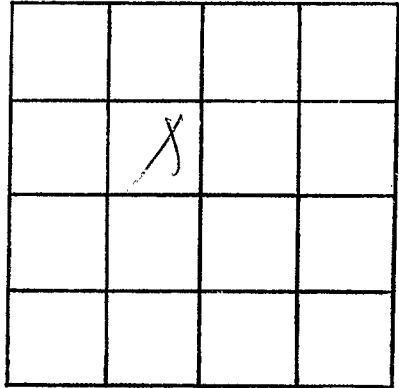

SECTION 19

Please indicate well location X.

ADDITIONAL INFORMATION

A series of horizontal lines for writing additional information.

If more than one screen, show locations of each on sketch.