

CODED

MISSISSIPPI
BOARD OF WATER COMMISSIONERS
416 North State Street
Jackson, Mississippi 39201

TALLAHATCHIE
G 22,
10-9-72

WATER WELL DRILLERS LOG

10-9 1972 James R. Lipe Tallahatchie
date well completed firm name county well located

LANDOWNER: Shuford Ware
Charleston
Miss.
(mailing address)

WELL LOCATION:
sec. 3 T 25 N R 3 E
S W
2 miles west of Oakland
(distance) (direction) (nearest town)

WELL PURPOSE: HOME
(home, irrigation, municipal, industrial)

WELL COMPLETION DATA:
(1) diameter (inches) 4"
(2) total depth (feet) 176
(3) static water level (feet) 100 below above top of ground.
(4) casing PVC 166 (material) (depth)
4 (size) if telescope see back.
(5) screen 10 166 (length) (depth to top)
4 PVC (size) (material)
(6) pump 3/4 12 (HP) (yield gpm)
Elec. (type power)
(7) electric log NO (yes or no)
NO (organization running log)
(8) how well bottom plugged PVC Plug

description of formations encountered	from	to
clay	0	28
"	20	40
sand and clay	40	60
"	60	80
gravel	80	100
"	100	110
sand	110	120
"	120	140
sand and clay	140	160
sand	160	176


CODED

DRILLERS REMARKS:

NOV 1 1972

If well telescopes please sketch and show depths.

GROUND LEVEL

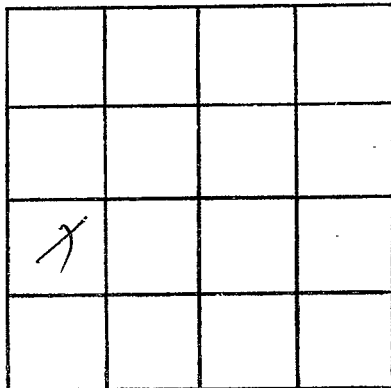

SECTION 3

Please indicate well location X.

ADDITIONAL INFORMATION

If more than one screen,
show locations of each on sketch.