

TALLAHATCHIE
 G 23
 10-12-72

MISSISSIPPI
 BOARD OF WATER COMMISSIONERS
 416 North State Street
 Jackson, Mississippi 39201

CODED

WATER WELL DRILLERS LOG

10-12-72 date well completed
 1972 James A. Lipe firm name
 Tallahatchie county well located

LANDOWNER: Walter Lucas
 Oakland
 Miss.
 (mailing address)

description of formations encountered	from	to
Clay	0	20
ll	20	40
sand and gravel	40	60
ll ll ll ll	60	80
ll ll ll ll	80	100
sand	100	120
ll	120	140
ll	140	161

WELL LOCATION:
 sec. 2 T 25 N R 3 E
 2 miles west of Oakland
 (distance) (direction) (nearest town)

WELL PURPOSE: HOME
 (home, irrigation, municipal, industrial)

CODED

WELL COMPLETION DATA:

- (1) diameter (inches) 4"
- (2) total depth (feet) 161
- (3) static water level (feet) 130 below top of ground.
- (4) casing PVC 147 (material) (depth)
 4 (size) If telescope see back.
- (5) screen 14 147 (length) (depth to top)
 4 PVC (size) (material)
- (6) pump 3/4 12 (HP) (yield gpm)
 Elec. (type power)
- (7) electric log NO (yes or no)
 NO (organization running log)
- (8) how well bottom plugged PVC Plug


NOV - 1 1972

DRILLERS REMARKS:

MISS. REG. NO.
 LICENSE NO. 111

If well telescopes please sketch and show depths.

GROUND LEVEL

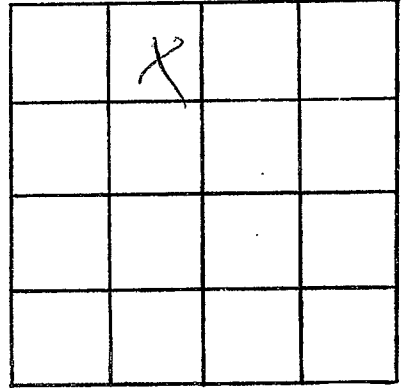

SECTION 9

Please indicate well location X.

ADDITIONAL INFORMATION

If more than one screen,
show locations of each on sketch.