

TALLAHATCHIE
G 24
7-26-73

MISSISSIPPI
 BOARD OF WATER COMMISSIONERS
 416 North State Street
 Jackson, Mississippi 39201

CODED

WATER WELL DRILLERS LOG

7-26 1973 James R. Lipe Tallahatchie
 date well completed firm name county well located

LANDOWNER:
Benny C. Champion
Charleston Miss.
 (mailing address)

description of formations encountered	from	to
	<u>clay</u>	<u>0</u>
<u>white sand</u>	<u>20</u>	<u>40</u>
<u>ll ll</u>	<u>40</u>	<u>88</u>

WELL LOCATION:
 sec. 11 T. 25 N. R. 3 E.
5 miles S. W. of Charleston
 (distance) (direction) (nearest town)

WELL PURPOSE:
 home irrigation, municipal, industrial

CODED

WELL COMPLETION DATA:

(1) diameter (inches) 4

(2) total depth (feet) 28

(3) static water level (feet) 30 below above top of ground.

(4) casing PVC 68
 (material) (depth)

4 if telescope see back.
 (size)

(5) screen 10 68
 (length) (depth to top)

4 PVC
 (size) (material)

(6) pump 3/4 10
 (HP) (yield gpm)

elec
 (type power)

(7) electric log no
 (yes or no)

no
 (organization running log)


(8) how well bottom plugged pvc plug

DRILLERS REMARKS:

JUL 30 1973

If well telescopes please sketch and show depths.

GROUND LEVEL

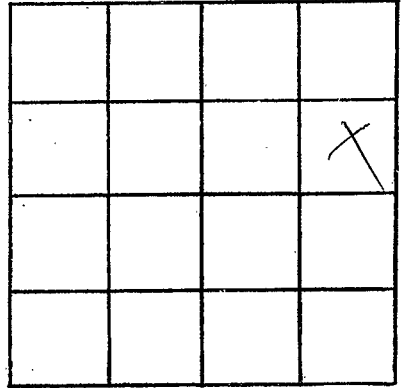

SECTION 11

Please indicate well location X.

ADDITIONAL INFORMATION

If more than one screen, show locations of each on sketch.