

Tallahatchie
 G 25
 9-3-73

MISSISSIPPI
 BOARD OF WATER COMMISSIONERS
 416 North State Street
 Jackson, Mississippi 39201

CODED

WATER WELL DRILLERS LOG

9-3-73 date well completed
 73 James R. Lipe firm name
 Tallahatchie county well located

LANDOWNER:
 Edward Harper
 Cascilla Miss.
 (mailing address)

WELL LOCATION:
 sec. 28^N 25^N R. 3^E
 S. W. Cascilla
 2 miles (distance) S.W. (direction) of Cascilla (nearest town)

WELL PURPOSE:
 (home, irrigation, municipal, industrial)

- WELL COMPLETION DATA:
- (1) diameter (inches) 4
 - (2) total depth (feet) 252
 - (3) static water level (feet) 130 below above top of ground.
 - (4) casing PVC 142,
 (material) (depth)
4 if telescope see back.
 (size)
 - (5) screen 10 142
 (length) (depth to top)
4 PVC
 (size) (material)
 - (6) pump 3/4 10
 (HP) (yield gpm)
CEC
 (type power)
 - (7) electric log NO
 (yes or no)
NO
 (organization running log)
 - (8) how well bottom plugged PVC CAP

description of formations encountered	from	to
Top Soil	0	20
Clay	20	40
red sand	40	60
ll ll	60	80
Gravel	80	100
ll	100	120
Clay	120	140
ll	140	160
ll	160	180
Sand and clay	180	200
ll ll ll	200	220
ll ll ll	220	240
sand	240	252


CODED

DRILLERS REMARKS:

OCT 9 1973

If well telescopes please sketch and show depths.

GROUND LEVEL

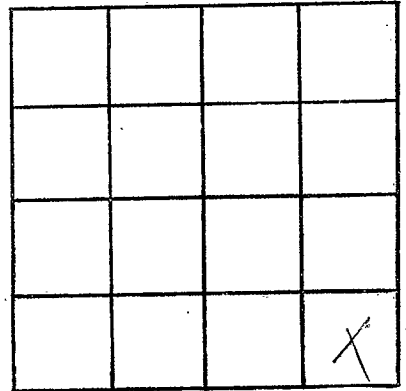

SECTION 28

Please indicate well location X.

ADDITIONAL INFORMATION

If more than one screen,
show locations of each on sketch.