

TALLAHATCHIE
 G 26
 10-9-73

MISSISSIPPI
 BOARD OF WATER COMMISSIONERS
 416 North State Street
 Jackson, Mississippi 39201

WATER WELL DRILLERS LOG

10-9 1973 Lipe Well Co. Tallahatchie
 date well completed firm name county well located

LANDOWNER:
 Arther King
 Charleston Miss.
 (mailing address)

WELL LOCATION:
 sec. 10 T 25 N R 3 E S W
 2 miles West of Oakland
 (distance) (direction) (nearest town)

WELL PURPOSE:
 (home) Irrigation, municipal, industrial

WELL COMPLETION DATA:

(1) diameter (inches) 4
 (2) total depth (feet) 160
 (3) static water level (feet) 125 below top of ground.
 (4) casing PVC 150 (material) (depth)
 4 (size) if telescope see back.
 (5) screen 10 150 (length) (depth to top)
 4 PVC (size) (material)
 (6) pump 3/4 10 (HP) (yield gpm)
 elec. (type power)
 (7) electric log NO (yes or no)
 NO (organization running log)
 (8) how well bottom plugged PVC plug

description of formations encountered	from	to
TOP soil	0	20
red sand	20	40
" "	40	60
gravel	60	80
" "	80	100
sand	100	120
" "	120	140
" "	140	160

CODED


DRILLERS REMARKS:

NOV 5 1973

MISC. DATA

If well telescopes please sketch and show depths.

GROUND LEVEL

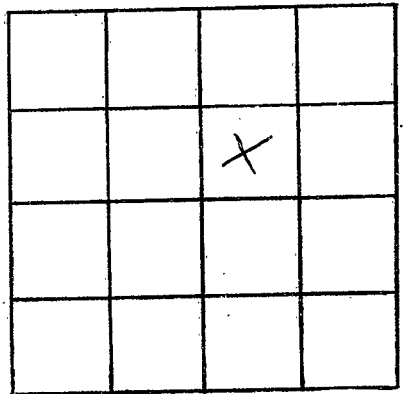

SECTION 10

Please indicate well location X.

ADDITIONAL INFORMATION

If more than one screen, show locations of each on sketch.