

Tallahatchie
 G30
 9-3-74

MISSISSIPPI
 BOARD OF WATER COMMISSIONERS
 416 North State Street
 Jackson, Mississippi 39201

CODED

WATER WELL DRILLERS LOG

9-3 1974 Life Well Co Tallahatchie
 date well completed firm name county well located

LANDOWNER:
Charles Ross,
Charleston Miss.
 (mailing address)

description of formations encountered	from	to
Top Soil	0	20
red sand	20	40
" "	40	80
GRAVEL	80	80
" "	80	100
sand and wt. clay	100	120
white sand	120	176

WELL LOCATION:
 sec. 26 T 25 N R 3 E
 S W
8 miles S.E. of Charleston
 (distance) (direction) (nearest town)

WELL PURPOSE:
 (home) irrigation, municipal, industrial

- WELL COMPLETION DATA:
- (1) diameter (inches) 4
- (2) total depth (feet) 176
- (3) static water level (feet) 120 below above top of ground.
- (4) casing POC 166
 (material) (depth)
4 if telescope see back.
 (size)
- (5) screen 10 166
 (length) (depth to top)
4 POC
 (size) (material)
- (6) pump 3/4 10
 (HP) (yield gpm)
C/elec
 (type power)
- (7) electric log NO
 (yes or no)
NO
 (organization running log)
- (8) how well bottom plugged PVC
plug


RECEIVED

SEP 30 1974

DRILLERS REMARKS:

If well telescopes please sketch and show depths.

GROUND LEVEL

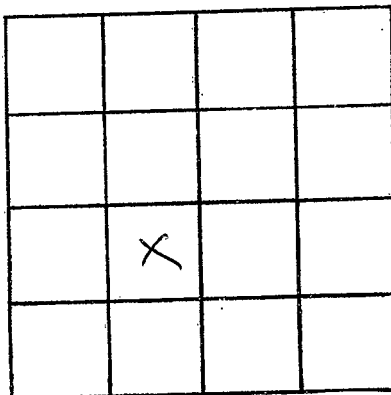

SECTION 26

Please indicate well location X.

ADDITIONAL INFORMATION

If more than one screen,
show locations of each on sketch.