

MISSISSIPPI DEPARTMENT OF NATURAL RESOURCES

Bureau of Land and Water Resources

Southport Mall

P.O. Box 10631

Jackson, Mississippi 39209

WATER WELL DRILLERS LOG

CODED

TALLAHATCHIE

YALOBUSHA

TALLAHATCHIE
 CL-2896
 62000
 3-12-85

3-12 1985


LAYNE CENTRAL CO.

date well completed

firm name

county well located


LANDOWNER:	description of formations encountered	from	to
SPRINGHILL WATER ASSN.	red sandy clay	0	27
OAKLAND, MS	coarse sand	27	58
(mailing address)	coarse sand & pea gravel	58	74
WELL LOCATION:	clay	74	97
sec. 22 T. 25 N R. 3 E	sandy clay	97	120
6 miles east of Charleston	stks. of sand w/clay	120	155
(distance) (direction) (nearest town)	clay	155	187
WELL PURPOSE: municipal	sand w/stks. of shale	187	383
(home, irrigation, municipal, industrial)	fine sand	383	415
WELL COMPLETION DATA:	stks. of sand w/shale	415	455
(1) diameter (inches) 19"	sand & stks. of clay	455	511
(2) total depth (feet) 564' 7"	sand	511	556
(3) static water level (feet) 143 below top of ground.	clay	556	581
(4) casing steel 519' (material), (depth)	rock	581	582
8" (size) if telescope see back.	clay	582	597
(5) screen 40' 7" 519' (length), (depth to top)	rock	597	598
4" st. steel (size), (material)	clay	598	607
(6) pump 10 150 (HP), (yield gpm)	stks. of sand & shale	607	617
elec. (type power)	sandy shale	617	632
(7) electric log yes (yes or no)	sandy clay	632	663
Layne (organization running log)	hard clay	663	685
(8) how well bottom plugged 4" BP valve	shale	685	814
DRILLERS REMARKS:	clay	814	873
	sandy shale	873	914
	stks. of fine sand w/shale	914	951
	clay	951	964

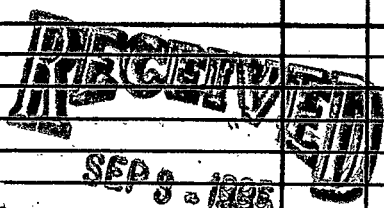

Department of Natural Resources
 Bureau of Land & Water Resources

If well telescopes please
sketch and show depths.

GROUND LEVEL

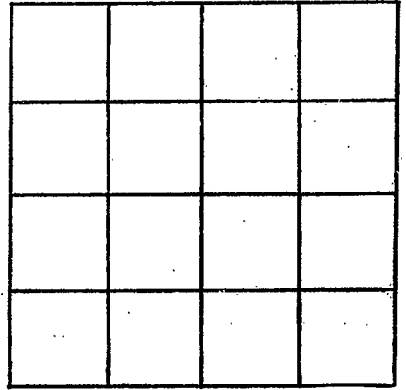

SECTION _____

Please indicate well location X.

ADDITIONAL INFORMATION

If more than one screen,
show locations of each on sketch.