

ELOG # 33

Tallahatchie  
H 13  
9-67  
Elec Log

MISSISSIPPI  
BOARD OF WATER COMMISSIONERS  
416 North State Street  
Jackson, Mississippi 39201

CODED

WATER WELL DRILLERS LOG

SEPT. 26, 1967 DELTA DRILLING Co. TALLAHATCHIE  
date well completed firm name county well located

LANDOWNER: KING COTTON BEVERAGE Co.  
HI-WAY SUBDIVISION

SUMNER, MISS  
(mailing address)

WELL LOCATION: SW 1/4 - SE 1/4 NW  
sec. 11 T24 N R 2 W  
miles at of Sumner  
(distance) (direction) (nearest town)

WELL PURPOSE: MUNICIPAL  
(home, irrigation, municipal, industrial)

WELL COMPLETION DATA:

- (1) diameter (inches) 6
- (2) total depth (feet) 1068
- (3) static water level (feet) 5 below top of ground.

(4) casing STEEL, 1068, (material) (depth)  
6-4-2 1/2 if telescope see back. (size)


(5) screen 20, SEE REVERSE (length) (depth to top)  
2 1/2", S. STEEL (size) (material)

(6) pump (HP) (yield gpm)  
✓ (type power)

(7) electric log YES (yes or no)  
U.S.G.S. (organization running log)

(8) how well bottom plugged BACK PRESSURE VALVE

description of formations encountered	from	to
GUMBO	0	21
Sand	21	61
Gravel	61	124
GUMBO	124	167
Sand	167	231
GUMBO	231	311
Sand	311	393
Shale	393	456
Sand	456	476
GUMBO w/ROCKS	476	520
Sand w/ROCKS	520	578
Shale	578	609
green sand	609	677
Shale	677	741
green sand	741	763
Shale	763	782
Brown sand	782	804
Shale	804	827
Sand	827	867
GUMBO	867	888
Shale	888	929
GUMBO	929	970
Sand	970	982
Shale	982	998
Sand	998	1020
GUMBO	1020	1029
Shale w/ROCK	1029	1050
Sand	1050	1068

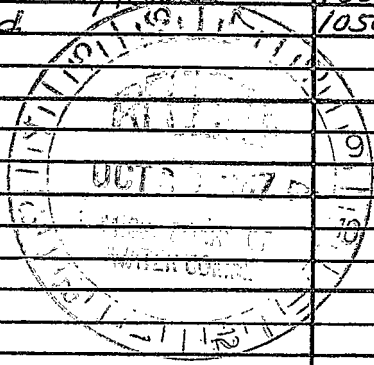

DRILLERS REMARKS:

NO PUMP INSTALLED AT THIS TIME

If well telescopes please sketch and show depths.

GROUND LEVEL

262'-6"  
BLK API  
LINE PIPE

350'-4" Pipe

23' LAP OF  
2 1/2" IN 4"


170'-2 1/2" Pipe

10'-2 1/2" SS  
Screen

225'-2 1/2" Pipe

10'-2 1/2" SS  
Screen

64'-2 1/2"  
Tail pipe

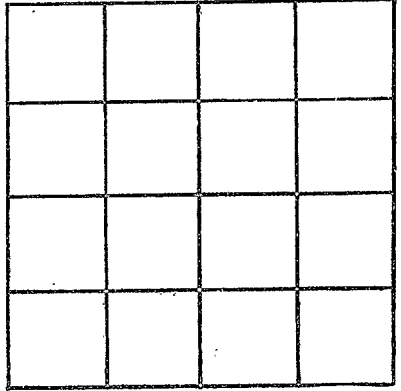

SECTION 11

Please indicate well location X.

ADDITIONAL INFORMATION

If more than one screen,  
show locations of each on sketch.