

If well telescopes please sketch and show depths.

GROUND LEVEL

4" Galv
Pipe


4"
124 FT

2" Galv
Pipe

2"
990 FT

2"
Standard
Steel
Screen

2"
20 FT

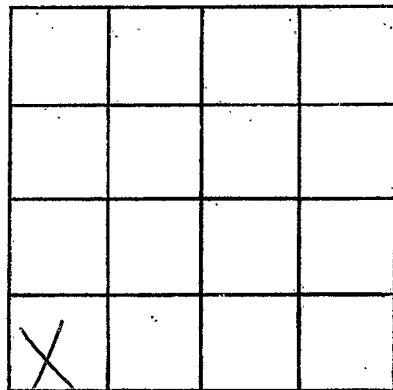

SECTION _____

Please indicate well location X.

ADDITIONAL INFORMATION

If more than one screen,
show locations of each on sketch.