

TALLAHATCHIE

~~SUNFLOWER~~

H 18

4-29-71

MISSISSIPPI
BOARD OF WATER COMMISSIONERS
416 North State Street
Jackson, Mississippi 39201

CODED
C3452

WATER WELL DRILLERS LOG

April 29, 1971 SINGER-Layne Central Division Sunflower
date well completed firm name county well located

LANDOWNER: John W. Whatley

Drew, Mississippi

(mailing address)

WELL LOCATION:

sec. 16 T 24 N R 2 EXX
EXX W

7 miles east of Drew
(distance) (direction) (nearest town)

WELL PURPOSE: irrigation
(home, irrigation, municipal, industrial)

WELL COMPLETION DATA:

- (1) diameter (inches) 16
- (2) total depth (feet) 97
- (3) static water level (feet) 12' below above top of ground.
- (4) casing steel 57'
(material) (depth)
16" If telescope see back.
(size)
- (5) screen 16" 97'
(length) (depth to top)
16" steel
(size) (material)
- (6) pump 50 2000
(HP) (yield gpm)
electric
(type power)
- (7) electric log no
(yes or no)

(organization running log)

(8) how well bottom plugged plate

DRILLERS REMARKS:

description of formations encountered

from

to

Clay	0	24
Coarse sand	24	35
Coarse sand, pea gravel & lignite	35	65
Coarse sand, gravel	65	97
Rock		97


CODED

MAY 18 1971

MISS. Bd. OF
WATER COMMISSIONERS
JACKSON, MISSISSIPPI

If well telescopes please sketch and show depths.

GROUND LEVEL

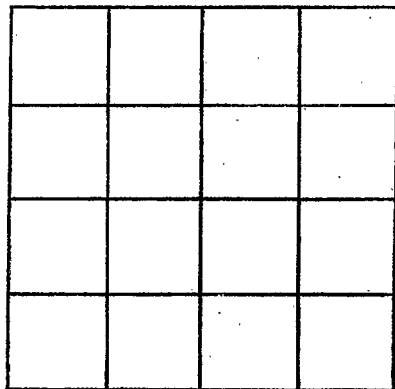

SECTION _____

Please indicate well location X.

ADDITIONAL INFORMATION

If more than one screen,
show locations of each on sketch.