

TALLA.  
H-23  
2-19-57

MISSISSIPPI BOARD OF WATER COMMISSIONERS

WATER WELL DRILLERS LOG

4/15/65  
2306  
Jm

Date: Feb. 19, 19 57, Driller: Layne-Central Company County Tallahatchie

**CODED**

(Name)

**CODED**

(1) Owner of Land: Morrow Brothers  
(Name)

Description & Color of Soil  
Sand, Clay, Red Clay, Shell, etc.

Depth  
Feet

Webb, Mississippi  
(Address)

Clay 15 15

(2) Location: 1/4, 1/4, Sec. 33, 34, 24R2W

Fine sand 10 25

7 miles South-west of Webb  
(distance) (direction) (Nearest Town)

Coarse sand 15 40

(3) Topography: flat  
(Hilly) (Flat) (Level)

Coarse sand & pea gravel 20 60

(4) Purpose of Well: irrigation  
(Domestic Irrigation  
Municipal, Industrial, Other)

Coarse sand & pea gravel 57 117

Information upon completion of well:

(1) Diameter 16x12 inches.

**CODED**

(2) Total Depth 117 feet.

(3) Water Level 15'-2" feet below top of ground.

(4) Cased to 62' Size 16"  
5' of 12" blank

(5) Screen: Size 12", Length 50'

(6) Were any formations sealed against pollution?

no yes, no no.


If YES depth of formation \_\_\_\_\_

Why \_\_\_\_\_

Drillers Remarks: \_\_\_\_\_

2232 GPM

engine drive

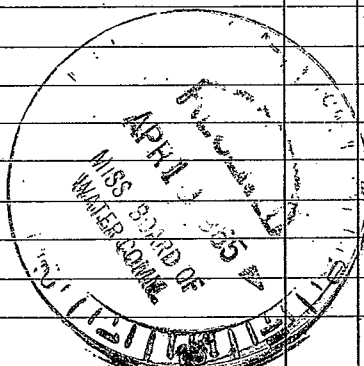

(Use Back Side)

Well No.

1952

1952

1952

1952