

Tallahassee
H-2524
11-65

MISSISSIPPI BOARD OF WATER COMMISSIONERS

WATER WELL DRILLERS LOG

CODED

Date: 11-4-65, Driller: Layne-Central Co. County Talla.

CODED

(1) Owner of Land: Town of Sumner
(Name)
Sumner, Mississippi
(Address)

(2) Location: SE 1/4, SE 1/4, Sec. 2 R4N R2W
in Sumner
miles (distance), of (direction), of (Nearest Town)

(3) Topography: _____
(Hilly) (Flat) (Level)

(4) Purpose of Well: Municipal
(Domestic Irrigation
Municipal, Industrial, Other)

Information upon completion of well:

(1) Diameter 10 inches.

(2) Total Depth 881 feet.

(3) Water Level 13' feet below top of ground.

(4) Cased to 810', Size 10"

(5) Screen: Size 6", Length 60'


(6) Were any formations sealed against pollution?
X yes, _____ no.

If YES depth of formation 810'

Why required

Drillers Remarks: _____

Description & Color of Materials Sand, Clay, Red Clay, Shell, etc.	Thick- ness Feet	Depth Feet
clay	25	0
sand	8	83
sand-gravel	58	204
clay	15	219
hard shale-boulders		297
sandy shale	78	304
shale stks-sand	16	320
soft sandy shale	23	343
sand	103	446
sand	10	447
tough clay	13	460
clay+boulders		620
rock	1	621
clay boulders	22	643
shale	125	768
shale-sand sts.	14	782
shale-sand sts.	23	805
shale	9	813
sand	15	828
sand	10	838
shale	5	843
sand	6	849
shale	13	862
sand	15	877
shale	8	885
sand	6	891
shale	29	920

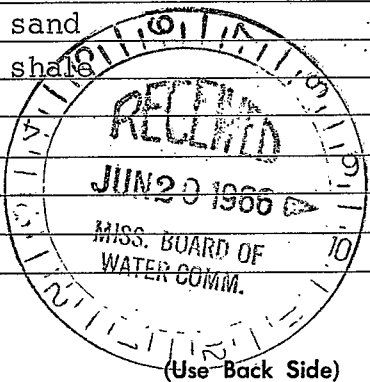

Well No.

