

TALLAHATCHIE
H 26
4-5-73

MISSISSIPPI
BOARD OF WATER COMMISSIONERS
416 North State Street
Jackson, Mississippi 39201

CODED

WATER WELL DRILLERS LOG

4/6 1973 Dutton Well & Supply Co. Tallahatchie
date well completed firm name county well located

LANDOWNER:
Lewis Broadland
PT 1 - Box 259, Drew - Miss.
(mailing address)

description of formations encountered	from	to
<u>Top Soil</u>	<u>0</u>	<u>20</u>
<u>Thin Sand</u>	<u>20</u>	<u>45</u>
<u>Coarse Sand</u>	<u>45</u>	<u>80</u>
<u>Coarse Sandy Silt</u>	<u>80</u>	<u>140</u>
<u>Clay</u>	<u>140</u>	<u>315</u>
<u>Sandstone</u>	<u>315</u>	<u>340</u>
<u>Clay</u>	<u>340</u>	<u>600</u>
<u>Thin Sand</u>	<u>600</u>	<u>660</u>
<u>Clay & Shale</u>	<u>660</u>	<u>714</u>
<u>Clay</u>	<u>714</u>	<u>800</u>
<u>Clay & Rocky Breaks</u>	<u>800</u>	<u>860</u>
<u>Shale & Clay</u>	<u>860</u>	<u>995</u>
<u>Iron & Manganese</u>	<u>995</u>	<u>1113</u>

WELL LOCATION:
sec. 18 T 24 N R 2 E
3 miles East of Broadman
(distance) (direction) (nearest town)

WELL PURPOSE: House
(home, irrigation, municipal, industrial)

- WELL COMPLETION DATA:
- (1) diameter (inches) 4 x 2
 - (2) total depth (feet) 1050
 - (3) static water level (feet) 12 below above top of ground.
 - (4) casing: galv. pipe
(material) (depth)
(size) if telescope see back.
 - (5) screen 20
(length) (depth to top)
2 Stainless Steel
(size) (material)
 - (6) pump 1 19
(HP) (yield gpm)
elec
(type power)
 - (7) electric log NO
(yes or no)
(organization running log)
 - (8) how well bottom plugged BP's valve

CODED



DRILLERS REMARKS:

MISSISSIPPI BOARD OF WATER COMMISSIONERS
JAN 23 1973

MISS. PD. OF
WATER

If well telescopes please sketch and show depths.

GROUND LEVEL

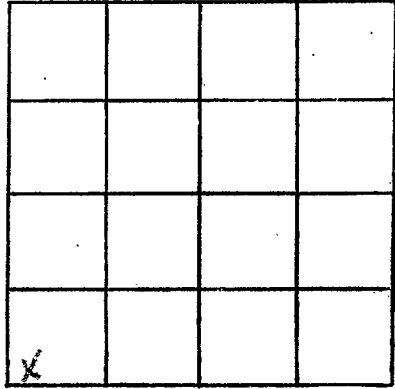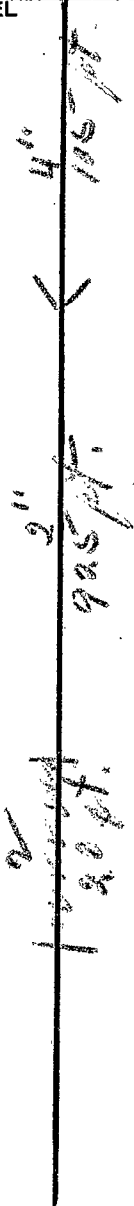

SECTION 18

Please indicate well location X.

ADDITIONAL INFORMATION

If more than one screen, show locations of each on sketch.