

Tallahatchie
H 21
3-67

MISSISSIPPI
BOARD OF WATER COMMISSIONERS
416 North State Street
Jackson, Mississippi 39201

CODED

4/14/67
C2405

WATER WELL DRILLERS LOG

March 29, 1967 Layne-Central Company Tallahatchie
date well completed firm name county well located

LANDOWNER: J. L. Webb

description of formations encountered	from	to
Clay	0	28
Clay balls, blue	28	45
Coarse sand, pea gravel	45	78
Coarse sand, gravel	78	117
Big boulders		117

Parma, Missouri
(mailing address)

WELL LOCATION:
sec. 5 T 24 N R 2 E S W
3 miles south of Tutwiler
(distance) (direction) (nearest town)


WELL PURPOSE: irrigation
(home, irrigation, municipal, industrial)

WELL COMPLETION DATA:

- (1) diameter (inches) 16"
- (2) total depth (feet) 117'
- (3) static water level (feet) 11.2' ~~below~~ above top of ground.
- (4) casing steel 69'
(material) (depth)
16" if telescope see back.
(size)
- (5) screen 48' 117'
(length) (depth to top)
16" Friedman
(size) (material)
- (6) pump 60 2000
(HP) (yield gpm)
Elec.
(type power)
- (7) electric log no
(yes or no)
(organization running log)
- (8) how well bottom plugged plate

CODED


117
48
69

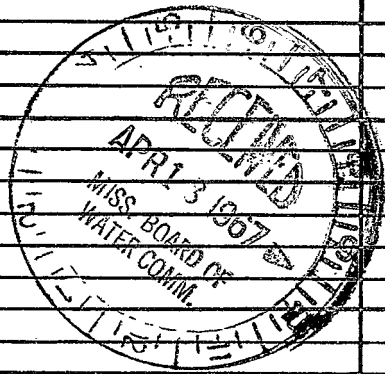

DRILLERS REMARKS:

If well telescopes please sketch and show depths.

GROUND LEVEL

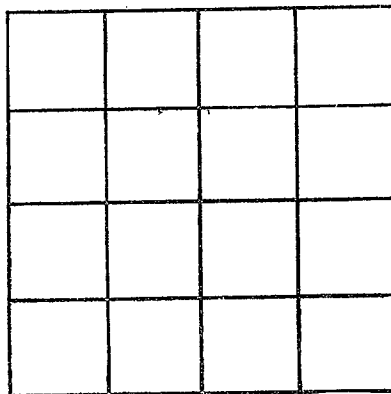

SECTION _____

Please indicate well location X.

ADDITIONAL INFORMATION

A series of horizontal lines for recording additional information, starting below the 'ADDITIONAL INFORMATION' header and extending to the bottom of the page.

If more than one screen, show locations of each on sketch.