

TALLAHATCHIE
H 30
4-8-75

MISSISSIPPI
BOARD OF WATER COMMISSIONERS
416 North State Street
Jackson, Mississippi 39201

CODED

WATER WELL DRILLERS LOG

4/8/75 19 FIVE COUNTY FARMERS ASSN TALLAHATCHIE
date well completed firm name county well located

LANDOWNER: ED GRAHAM
SUMNER, MISS.
(mailing address)

description of formations encountered	from	to
TOP SOIL SANDY	0	6
CLAY	12	36
SAND	36	48
SAND & PEA GRAVEL	48	118'

WELL LOCATION:
sec. 31 T 24 N R 2 E
2.5 miles WEST of PARCHEMAN
(distance) (direction) (nearest town)

WELL PURPOSE:
(home, irrigation, municipal, industrial)

- WELL COMPLETION DATA:
- (1) diameter (inches) 16"
 - (2) total depth (feet) 118.5
 - (3) static water level (feet) 4 below top of ground.
 - (4) casing BLACK PIPE 70' (material) (depth)
16" (size) if telescope see back.
 - (5) screen 48' 70' (length) (depth to top)
16" BLACK LOUVRE (size) (material)
 - (6) pump 80 3000 (HP) (yield gpm)
DIESEL POWER UNIT (type power)
 - (7) electric log No (yes or no)
 - (organization running log)
 - (8) how well bottom plugged WELDED


CODED

REGISTERED
APR 10 1975
MISS. BD. OF WATER COMMISSIONERS

DRILLERS REMARKS:

If well telescopes please sketch and show depths.

GROUND LEVEL

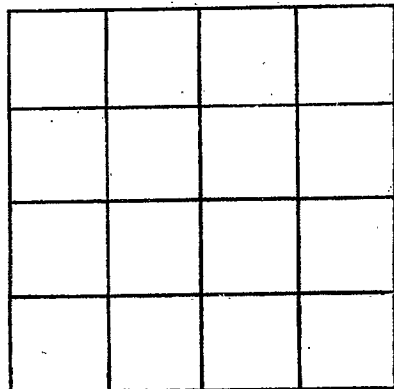

SECTION _____

Please indicate well location X.

ADDITIONAL INFORMATION

If more than one screen, show locations of each on sketch.