


**Tallahatchie**  
**H 32**  
**3-21-75**

**MISSISSIPPI BOARD OF WATER COMMISSIONERS**  
 416 North State Street  
 Jackson, Mississippi 39201

**WATER WELL DRILLERS LOG**


**CODED**

March 21, 1975 Singer-Layne Central Div. Tallahatchie  
 date well completed firm name county well located

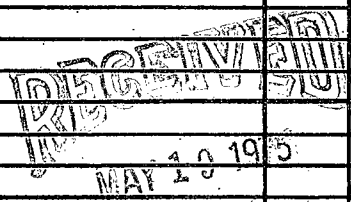LANDOWNER:	description of formations encountered	from	to
William H. Morrow Webb, MS (mailing address)	Clay	0	26
WELL LOCATION: sec. 21 T 24 N R 2 W	Sand	26	35
5 miles East of Parchman (distance) (direction) (nearest town)	Med. Coarse Sand	35	47
WELL PURPOSE: irrigation (home, irrigation, municipal, industrial)	Coarse Sand	47	55
WELL COMPLETION DATA:	Coarse Sand & Pea Gravel	55	76
(1) diameter (inches) 16"	Coarse Sand & Gravel	76	97
(2) total depth (feet) 97'			
(3) static water level (feet) 14 below top of ground.			
(4) casing steel 57' (material) (depth) 16" If telescope see back. (size)			
(5) screen 40' 57' (length) (depth to top) 16" steel (size) (material)			
(6) pump 40 2000 (HP) (yield gpm) engine (type power)			
(7) electric log no (yes or no)			
(organization running log)			
(8) how well bottom plugged with plate			
DRILLERS REMARKS:	 MAY 10 1975 MISSISSIPPI BOARD OF WATER COMMISSIONERS		

If well telescopes please sketch and show depths.

GROUND LEVEL

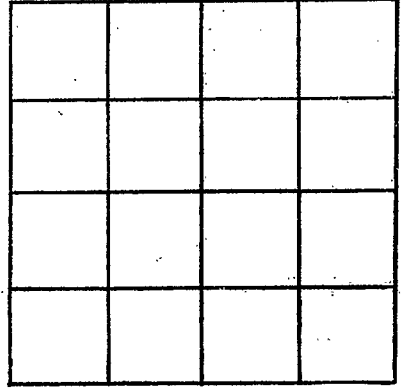

SECTION \_\_\_\_\_

Please indicate well location X.

ADDITIONAL INFORMATION

If more than one screen,  
show locations of each on sketch.