

Tallahatchie  
H 33  
4-8-75

MISSISSIPPI  
BOARD OF WATER COMMISSIONERS  
416 North State Street  
Jackson, Mississippi 39201

CODED

WATER WELL DRILLERS LOG


April 8, 19 75 *Singer - Rayne*  
date well completed firm name Tallahatchie  
county well located

LANDOWNER: <u>William H. Morrow</u> <u>P. O. Box 561</u>	description of formations encountered	from	to
<u>Webb, MS 38966</u> (mailing address)	Hard Clay	0	20'
WELL LOCATION: <u>sec. 22 T. 24 N</u> <u>R. 2 E</u> <sup>15H</sup> <u>X</u> <u>W</u>	Fine Sand	20	59'
<u>4</u> miles <u>East</u> of <u>Parchman</u> (distance) (direction) (nearest town)	Clay	59	70'
WELL PURPOSE: <u>irrigation</u> (home, irrigation, municipal, industrial)	Gravel	70	112'
WELL COMPLETION DATA:	<p style="text-align: center;">CODED</p>		
(1) diameter (inches) <u>16"</u>			
(2) total depth (feet) <u>112'</u>			
(3) static water level (feet) <u>10</u> <sub>below</sub> <sup>above</sup> top of ground.			
(4) casing <u>steel</u> <u>52'</u> (material) (depth)			
<u>16"</u> (size) if telescope see back.			
(5) screen <u>60'</u> <u>60'</u> (length) (depth to top)			
<u>16"</u> <u>Steel</u> (size) (material)			
(6) pump <u>50HP</u> <u>2,500</u> (HP) (yield gpm)			
<u>engine</u> (type power)			
(7) electric log <u>no</u> (yes or no)			
<u>(organization running log)</u>			
(8) how well bottom plugged <u>steel plate</u>			
DRILLERS REMARKS:   	<p style="text-align: center;">RECEIVED APR 14 1975 MISS. BD. OF WATER COMMISSIONERS</p>		

MISS. BD. OF WATER COMMISSIONERS

If well telescopes please sketch and show depths.

GROUND LEVEL

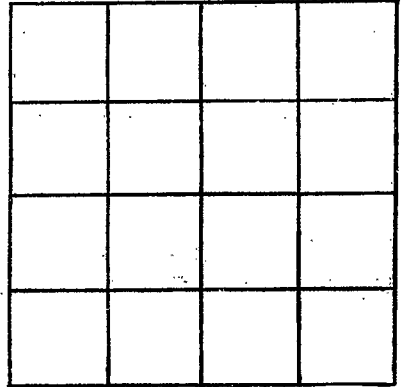

SECTION \_\_\_\_\_

Please indicate well location X.

ADDITIONAL INFORMATION

If more than one screen,  
show locations of each on sketch.