

OUR MAP DOES NOT SHOW

ROAD FROM WEBB TO

MISSISSIPPI TOWNE TWP AT

BOARD OF WATER COMMISSIONERS

416 North State Street

Jackson, Mississippi 39201

CODED
IS ON

WATER WELL DRILLERS LOG

TALLAHATCHIE
H 34
3-27-75

MARCH 27, 1975 date well completed Dyer-Sullivan, Inc. firm name Tallahatchie county well located

LANDOWNER: Charles Mester
 Tutwiler, Miss.
 (mailing address)

description of formations encountered	depth	
	from	to
Clay	0	33
Fine SAND	33	73
SAND & GRAVEL	73	113

WELL LOCATION:
 sec. 17 T 24 N R 2 E 15F
 ? S W

miles of (distance) (direction) (nearest town)

WELL PURPOSE: Irrigation
 (home, irrigation, municipal, industrial)

WELL COMPLETION DATA:

(1) diameter (inches) 16"

(2) total depth (feet) 113'

(3) static water level (feet) 15' below top of ground.

(4) casing BIC Iron, 73' (material) (depth)
 16" (size) if telescope see back.


(5) screen 40' 73' (length) (depth to top)
 16" BIC Inset (size) (material)

(6) pump 60 3000 (HP) (yield gpm)
 Diesel (type power)

(7) electric log No (yes or no)

(organization running log)

(8) how well bottom plugged Flate

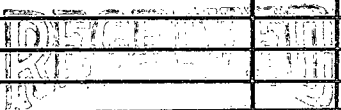


OCT 13 1975

DRILLERS REMARKS:

If well telescopes please sketch and show depths.

GROUND LEVEL

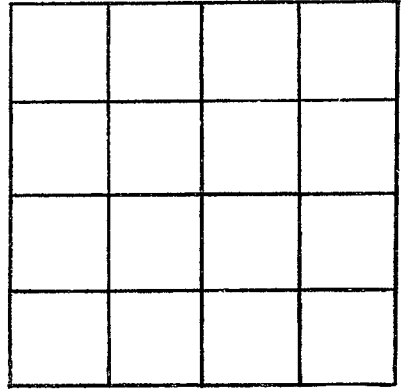

SECTION _____

Please indicate well location X.

ADDITIONAL INFORMATION

If more than one screen,
show locations of each on sketch.