

TALLAHATCHIE
H35
2-76
Elev 49

MISSISSIPPI
BOARD OF WATER COMMISSIONERS
416 North State Street
Jackson, Mississippi 39201

CODED

WATER WELL DRILLERS LOG

Feb 19 1976 Pipe Well & Supply Co. Tallahatchie
date well completed firm name county well located

LANDOWNER:
Leion of Sumner
Sumner, MS.
(mailing address)

description of formations encountered	from	to
Top soil & sand	0	87.9
Coarse sand + gravel	87.9	211
Hard clumbo	211	278
Fine sand	278	336
Sand	336	492
Shale + rocks	492	524
Sand + rocks	524	559
Sand + clay bands	559	581
Shale	581	589
Fine sand + rocks	589	741
Sand	741	786
Sand + clay bands	786	809
Sand + clay bands	809	899

WELL LOCATION:
sec. 11 T. 24 (N) R. 2 E
S (W)
(distance) miles (direction) of (nearest town)

WELL PURPOSE: Municipal
(home, irrigation, municipal, industrial)

- WELL COMPLETION DATA:
- (1) diameter (inches) 10"
 - (2) total depth (feet) 802'
 - (3) static water level (feet) 21' ^{below} _{above} top of ground.
 - (4) casing Steel (material) 741' (depth)
10 3/4" OD (size) If telescope see back.
 - (5) screen 100' (length) 742' (depth to top)
6" (size) S.S. (material)
 - (6) pump 40 (HP) 325 (yield gpm)
Electric (type power)
 - (7) electric log yes (yes or no)
MKS-USGS (organization running log)
 - (8) how well bottom plugged
Wash bottom

CODED


RECEIVED
JUN 21 1977

DRILLERS REMARKS:

MISS. BD. OF WATER COMMISSIONERS

If well telescopes please sketch and show depths.

GROUND LEVEL

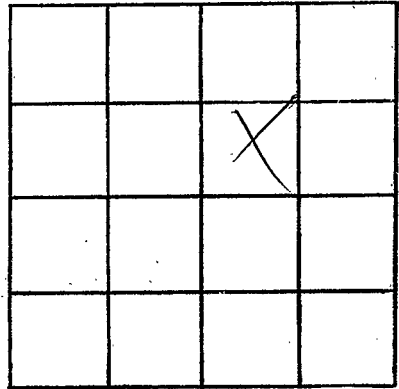

SECTION 11

Please indicate well location X.

ADDITIONAL INFORMATION

If more than one screen, show locations of each on sketch.