

TALLAHATCHIE

CL-0970

H37

~~3-28-77~~

8-9-78

8-9

1978

LAYNE CENTRAL CO.

TALLAHATCHIE

date well completed

firm name

county well located

MISSISSIPPI
BOARD OF WATER COMMISSIONERS
416 North State Street
Jackson, Mississippi 39201

CODED

WATER WELL DRILLERS LOG

LANDOWNER: Hoparka Plantation

Summer, MS

(mailing address)

description of fomations encountered

from

to

clay

0

15

med. sand

15

40

coarse sand & pea gr.

40

115

WELL LOCATION:

sec. 6 T. 24 N S

R. 2 E W

2 1/2 miles N of Webb

(distance) (direction) (nearest town)

CODED

WELL PURPOSE: Irrigation
(home, irrigation, municipal, industrial)

WELL COMPLETION DATA:

- (1) diameter (inches) 16"
- (2) total depth (feet) 115'
- (3) static water level (feet) 14' ^{below} top of ground.

(4) casing Steel, 74'4",
(material) (depth)
16" if telescope see back.
(size)

(5) screen 40'8", 74'4"
(length) (depth to top)
12 St. Steel
(size) (material)

(6) pump 40 2000
(HP) (yield gpm)
diesel
(type power)

(7) electric log no
(yes or no)

(organization running log)

(8) how well bottom plugged St. Plate

DRILLERS REMARKS:


Miss. Board of Water Comm.

MAR 27 1979

RECEIVED

If well telescopes please sketch and show depths.

GROUND LEVEL

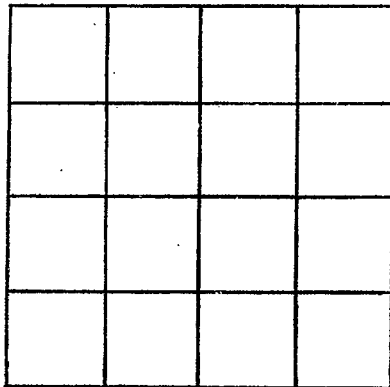

SECTION _____

Please indicate well location X.

ADDITIONAL INFORMATION

If more than one screen, show locations of each on sketch.