

Tallahatchie
H 38
9-24-79

MISSISSIPPI
BOARD OF WATER COMMISSIONERS
 416 North State Street
 Jackson, Mississippi 39201

CODED

WATER WELL DRILLERS LOG

BUTANE GAS COMPANY
OF GREENWOOD

9-24-79 19
 date well completed

Tallahatchie
 county well located

LANDOWNER:	description of formations encountered	from	to
John W. Whitted			
Sumner (mailing address)	SAND	30	65
	GRAVEL	65	130
WELL LOCATION:	Clay	130	155
sec. 10 T. 24 N. R. 2 E. S. 2 W.	SAND	155	190
2 miles E of Rome	Sandy Clay	190	220
(distance) (direction) (nearest town)	SHALE	220	360
WELL PURPOSE: Name	SAND + SHALE CODED	360	410
(home, irrigation, municipal, industrial)	Gummy shale	410	460
WELL COMPLETION DATA:	SAND	460	520
(1) diameter (inches) 4x2	SAND - SHALE ROCK	520	545
(2) total depth (feet) 1038	HARD SHALE + ROCK	545	700
(3) static water level (feet) 15 below top of ground.	SANDY SHALE	700	850
(4) casing Steel, 1008 (material), (depth)	SAND	850	930
4x2 (size) if telescope see back.	SANDY SHALE	930	970
(5) screen 30, 1008 (length), (depth to top).	SAND	970	1040
2" Stainless (size), (material)			
(6) pump 1, 20 (HP), (yield gpm)			
Elec. (type power)	10 BR 9 7/8 W Pump		
(7) electric log No (yes or no)	set on 60' 1" PVC		
(organization running log)			
(8) how well bottom plugged Back Pressure valve			
DRILLERS REMARKS:			

9/26/79
 [Signature]


If well telescopes please sketch and show depths.

GROUND LEVEL

105' 4" CASING →

903' 2" CASING →

30' 2" SCREEN →

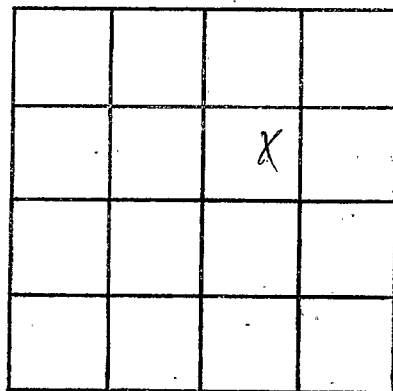

SECTION 10

Please indicate well location X.

ADDITIONAL INFORMATION

If more than one screen, show locations of each on sketch.