

Tallahatchee

H-39

6-4-80

MISSISSIPPI BOARD OF WATER COMMISSIONERS 416 North State Street Jackson, Mississippi 39201

CODED

WATER WELL DRILLERS LOG

6-4 date well completed 1980 Five Co. Farms, Inc. firm name Tallahatchee county well located

LANDOWNER: Jim Davis Keturba, Miss (mailing address)

Table with 3 columns: description of formations encountered, from, to. Entries include Top Clay, Fine sand, Coarse sand, fine lvs, sand & lvs with corresponding depth ranges.

WELL LOCATION: sec. 6 T 24 N S R 3 E W 4 miles west of Keturba (distance) (direction) (nearest town)

WELL PURPOSE: (home, irrigation, municipal, industrial)

- WELL COMPLETION DATA: (1) diameter (inches) 8" (2) total depth (feet) 115' (3) static water level (feet) 17 below top of ground. (4) casing PVC, 75' (depth) 8" (size) If telescope see-back. (5) screen 40' (length), 75' (depth to top) 8" (size), PVC (material) (6) pump 75 (HP), 1000 (yield gpm) deep well (type power) (7) electric log no (yes or no) (organization running log) (8) how well bottom plugged cap

DRILLERS REMARKS:


DEPT. OF NATURAL RESOURCES BUREAU OF LAND & WATER RESOURCES

MAR 25 1980

RECEIVED

If well telescopes please sketch and show depths.

GROUND LEVEL

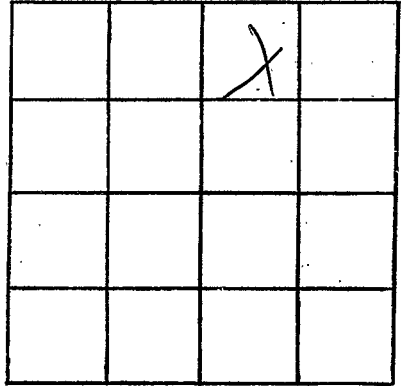

SECTION 6

Please indicate well location X.

ADDITIONAL INFORMATION

If more than one screen,  
show locations of each on sketch.