

Tallahatchie  
H 41  
3-10-80

MISSISSIPPI  
BOARD OF WATER COMMISSIONERS  
416 North State Street  
Jackson, Mississippi 39201

WATER WELL DRILLERS LOG

Tallahatchie

3/10 1980 Dyer Coahoma  
date well completed firm name county well located

LANDOWNER:  
HERB RATLIFF  
TUTWILER, MS  
(mailing address)


description of formations encountered	from	to
Clay <b>CODED</b>	0	30
Fine Sand	30	50
Coarse Sand Gravel + Solid rock (6')	50	103

WELL LOCATION:  
sec. 6 T 24 N R 2 E  
3 miles S of Tutwiler  
(distance) (direction) (nearest town)

WELL PURPOSE:  
(home, irrigation, municipal, industrial)

- WELL COMPLETION DATA:
- (1) diameter (inches) 12
  - (2) total depth (feet) 103'
  - (3) static water level (feet) 20' below top of ground.
  - (4) casing Steel, 103'  
(material) (depth)  
12" if telescope see back.  
(size)
  - (5) screen 40', 63'  
(length) (depth to top)  
12", Steel  
(size) (material)
  - (6) pump 40, 2000  
(HP) (yield gpm)  
Propane  
(type power)
  - (7) electric log             
(yes or no)  
            
(organization running log)
  - (8) how well bottom plugged flat

**CODED**

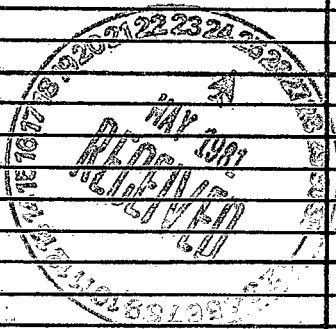

DRILLERS REMARKS:

If well telescopes please sketch and show depths.

GROUND LEVEL

1250.0

		X	

SECTION 6

Please indicate well location X.

ADDITIONAL INFORMATION

If more than one screen,  
show locations of each on sketch.