

Tallahatchie
H 42
64-80

MISSISSIPPI
BOARD OF WATER COMMISSIONERS
416 North State Street
Jackson, Mississippi 39201

WATER WELL DRILLERS LOG

6/4 1980 Dyer Tallahatchie
date well completed firm name county well located

LANDOWNER:

MARLEY-(BARGER)
WEBB, MS.
(mailing address)

description of formation encountered

CODED

from to

Clay	Δ	28
Fine sand		38
Sand		48
Sandy Gravel		100

WELL LOCATION:

sec. 2 T 24 (N) R 2 E
1 miles N of Seamer
(distance) (direction) (nearest town)


WELL PURPOSE: Domestic
(home, irrigation, municipal, industrial)

WELL COMPLETION DATA:

- (1) diameter (inches) 16"
- (2) total depth (feet) 100'
- (3) static water level (feet) 20' below top of ground.
- (4) casing Steel, 100'
(material) (depth)
16" if telescope see back.
(size)
- (5) screen 40', 60'
(length) (depth to top)
16", Steel
(size) (material)
- (6) pump 80, 1200
(HP) (yield gpm)
Diesel
(type power)
- (7) electric log
(yes or no)

(organization running log)
- (8) how well bottom plugged plate


CODED

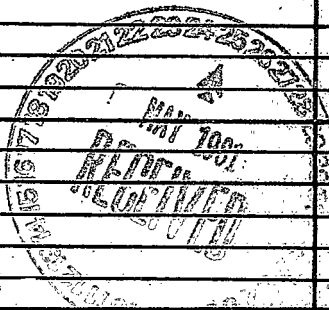

DRILLERS REMARKS:

If well telescopes please sketch and show depths.

GROUND LEVEL

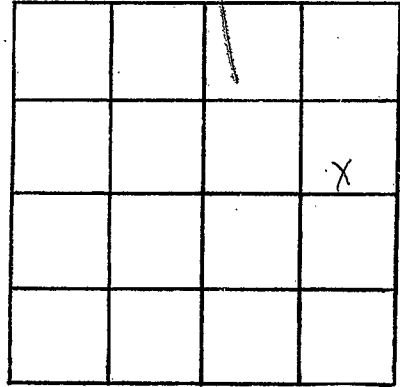

SECTION 2

Please indicate well location X.

ADDITIONAL INFORMATION

If more than one screen, show locations of each on sketch.