

MISSISSIPPI DEPARTMENT OF NATURAL RESOURCES

Bureau of Land and Water Resources

Southport Mall

P.O. Box 10631

Jackson, Mississippi 39209

WATER WELL DRILLERS LOG

BUTANE GAS COMPANY

OF GREENWOOD
firm name

CODED

TALLAHATCHIE
H 43
1-27-84

1-24-1984
date well completed

Tallahatchie
county well located

LANDOWNER:

M. H. Morley

(mailing address)

description of formations encountered

from

to

Clay
Sand & Gravel
0 65
65 105

WELL LOCATION:

sec. 30 T 24 N R 2 E
S W
1 miles S.E. of Webb
(distance) (direction) (nearest town)

WELL PURPOSE: Irrigation
(home, irrigation, municipal, industrial)

WELL COMPLETION DATA:

- (1) diameter (inches) 12"
- (2) total depth (feet) 105
- (3) static water level (feet) 35 below above top of ground.
- (4) casing Steel, 65 (material), (depth)
12" (size) if telescope see back.
- (5) screen 40', 65 (length), (depth to top)
12" steel (size), (material)
- (6) pump 80 (HP), 600 (yield gpm)
Diesel (type power)
- (7) electric log No (yes or no)
No (organization running log)

(8) how well bottom plugged
Steel plate

DRILLERS REMARKS:

Carlos Ramos


CODED

DEPT. OF NATURAL RESOURCES
BUREAU OF LAND & WATER RESOURCES

FEB 21 1984
RECEIVED

If well telescopes please sketch and show depths.

GROUND LEVEL

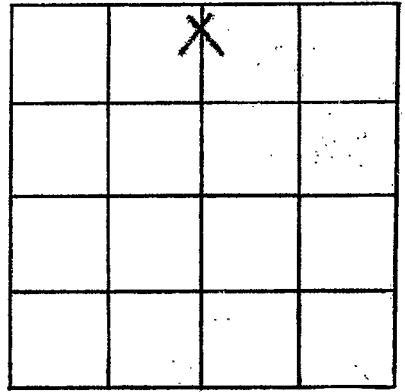

SECTION 30

Please indicate well location X.

ADDITIONAL INFORMATION

Lined area for additional information.

If more than one screen, show locations of each on sketch.