

MISSISSIPPI DEPARTMENT OF NATURAL RESOURCES

Bureau of Land and Water Resources

Southport Mall

P.O. Box 10631

Jackson, Mississippi 39209

WATER WELL DRILLERS LOG

CODED

July 31

1985

Bruce Berryman

Tallahatchie

date well completed

Greenwood, MS

county well located

LANDOWNER: Delta Rice Service.
P.O. Box 1133
Cleveland, MS

(mailing address)

WELL LOCATION:

sec. 24 T. 24 N R. 2 E
S 5 W
2 miles west of Webb.
(distance) (direction) (nearest town)

WELL PURPOSE: H.O.
(home, irrigation, municipal, industrial)

WELL COMPLETION DATA:

- (1) diameter (inches) 4" x 2"
- (2) total depth (feet) 818'
- (3) static water level (feet) 17' below top of ground
4' blk. - 147'
- (4) casing 4" gal. - 651'
(material) (depth)

_____ If telescope see back.
(size)

- (5) screen 20' 798'
(length) (depth to top)

2" .010 ga. stainless steel
(size) (material)

- (6) pump 2 h.p. 40
(HP) (yield gpm)

Electric
(type power)

- (7) electric log NO
(yes or no)

(organization running log)

- (8) how well bottom plugged B.P.V.

DRILLERS REMARKS:

description of formations encountered	from	to
Clay	0	40
Sand & Gravel	40	140
Brown shale	140	200
Shale & str. sand	200	240
Sand	240	400
Shale	400	440
Shale & hard rock	440	600
Sandy shale	600	620
Brown sand	620	640
Sand & str. shale	640	660
Shale	660	680
Sand	680	710
Shale	710	740
Sandy shale	740	760
Sand	760	840


CODED

RECEIVED
FEB 16 1986

Department of Natural Resources
Bureau of Land & Water Resources

If well telescopes please sketch and show depths.

GROUND LEVEL

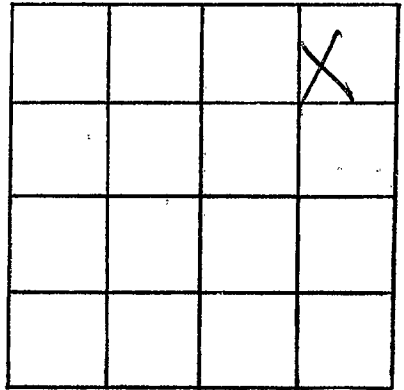

SECTION 20

Please indicate well location X.

ADDITIONAL INFORMATION

If more than one screen,
show locations of each on sketch.