

MISSISSIPPI DEPARTMENT OF NATURAL RESOURCES

Bureau of Land and Water Resources

Southport Mall

P.O. Box 10631

Jackson, Mississippi 39209

WATER WELL DRILLERS LOG

Tallahatchie
H 48

Capped

11-14 1990 date well completed
LIFE WELL + SUPPLY Co., Inc. firm name
Tallahatchie county well located

LANDOWNER: ERIC LIVINGSTON

Rt. 1 Box 257E

DREW, MS.

(mailing address)

WELL LOCATION:

sec. 31 T 24 N R 2 E
S W
2 miles WEST of Blue Lake
(distance) (direction) (nearest town)

WELL PURPOSE: Home
(home, irrigation, municipal, industrial)


WELL COMPLETION DATA:

- (1) diameter (inches) 4
- (2) total depth (feet) 520
- (3) static water level (feet) _____ below above top of ground.
- (4) casing PVC, 510 (material), (depth), 4 (size) if telescope see back.
- (5) screen 10, 510 (length), (depth to top), 4, PVC (size), (material)
- (6) pump 1 (HP), _____ (yield gpm)
(type power)
- (7) electric log _____ (yes or no)
(organization running log)
- (8) how well bottom plugged Capped

description of formations encountered

from to

Top soil, GRAY	0	20
GRAY clay, soft blue clay	20	40
soft clay - gravel	40	60
gravel	60	80
gravel	80	100
gravel - sand - gravel	100	120
Gravel - back into sand	120	140
sand	140	160
sand - clay - sand	160	180
sand	180	200
sand	200	220
sand	220	240
sand	240	260
sand	260	280
sand	280	300
sand	300	320
sand	320	340
sand END 346' - then clay	340	360
clay	360	380
clay	380	400
clay - streaks of sand	400	420
clay	420	440
clay - streaks of dust	440	460
clay-dust mixed - few streaks sand	460	480
sand	480	500
9' of sand - back to clay	500	520

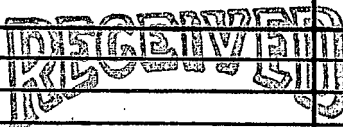


APR 16 1991

DRILLERS REMARKS:

Dept. of Environmental Quality
Bureau of Land & Water Resources

If well telescopes please sketch and show depths.

GROUND LEVEL

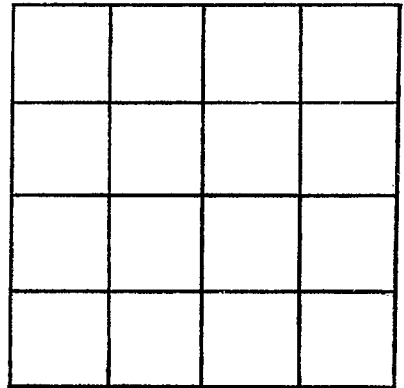

SECTION _____

Please indicate well location X.

ADDITIONAL INFORMATION

If more than one screen, show locations of each on sketch.