

MISSISSIPPI DEPARTMENT OF ENVIRONMENTAL QUALITY
Bureau of Land and Water Resources

108A
P. O. Box 10631
Jackson, MS 39289-0631
WATER WELL DRILLERS LOG

COUNTY WELL LOCATED Tallahatchie	
WELL NUMBER H 49	CODED <input checked="" type="checkbox"/>
DATE WELL COMPLETED 4-17-92	

PERMIT NUMBER
NAME OF DRILLING FIRM IRRIGATION EQUIPMENT
601/887-2555
INDIANOLA, MS

NAME & MAILING ADDRESS OF LANDOWNER RAY HAUSNER FARMS		
Rt. 1, BOX 209-A		
Clendora, MS 38928		
WELL LOCATION: SEC	TOWNSHIP	RANGE
27	24 ^N _S	2 ^E _W
DISTANCE	DIRECTION	NEAREST TOWN
3 Miles	SW	of Webb
OTHER LANDMARK TN GAS line		
WELL PURPOSE: Home, Irrigation, Municipal, Industrial, Fish Pond, etc. Irrigation Pivot		

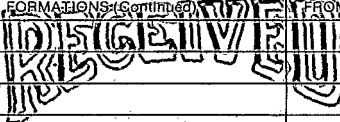
PUMP DATA		
PUMP TYPE (Circle One): Submersible, <u>Turbine</u> Jet Flowing Well, Other (Describe) _____		
POWER TYPE (Circle One): Electric, Tractor, <u>Diesel</u> Gasoline, Butane, Other (Describe) _____ H/P 80		
Pump Capacity (GPM) 1400	No. of Stages 3	Setting Depth 50 FT.
PUMP TEST		
Well yielded _____ GPM with a drawdown of _____ ft. after _____ hours of pumping		

WELL DATA		
Well Depth 115	Casing Diameter (In.) 12	Casing Length (Ft.) 75
Type of Casing steel	Hole Depth 115	Depth to Static Water Level 25'
TYPE OF COMPLETION: (Circle One or More): <u>Gravel Packed</u> , Underreamed, Telescoped, Natural Development, Open Hole, Other (Describe) _____		
Top of Lap Pipe or Reduction in Casing FEET IF TELESCOPED OR MORE THAN ONE SCREEN: USE BACK PAGE		

LOG DATA	
TYPE OF LOG RUN (Circle One): No Log Run, Electric, Gamma Ray, Density, Sonic, Neutron, Other (Describe) _____	
Name of Organization Running Log	

SCREEN DATA		
Diameter - Inches 12	Length - Feet 40	Slot Size - Inches 0.060
Screen Type steel	Depth to Bottom - Feet 115	

GEOLOGIC DATA (Office Use Only)			
Surface Elev.	Geologic Unit	Unit Thickness	Depth to Top
Subs. SWL	Date	Analysis	Aquifer Test
Driller's Remarks Circle S Pivot South well			

DESCRIPTION OF FORMATIONS ENCOUNTERED	FROM	TO	FORMATIONS (Continued)	FROM	TO
Fine sand	0	25	 JUN 24 1992 Dept. of Environmental Quality Bureau of Land & Water Resources		
medium sand	25	35			
COARSE SAND	35	65			
COARSE SAND + Gravel	65	115			

IF MORE SPACE IS NEEDED, USE BACK

If well telescopes please sketch and show depths.

GROUND LEVEL

			X

SECTION 27

Please indicate well location X.

ADDITIONAL INFORMATION

If more than one screen,
show location of each on sketch.